

Name

Harold C. Wilson

Service No.

Address

7 Hadley Road

Location

Kind of Pipe

Lot# 413 Sta. 5+28R

Size

Size of Main

Repair—Renewal—New Service

Ordinance #918

Location

J. M. Incicente Permit #454


Date	Material	Amount	Total	Date	Amount
8-25-65	24' 6" Transite pipe				
12-19-67	55' 6" Transite pipe				
	10' 4" Cast Iron Pipe			8-25-65	
				34' 6" Transite	

DATE _____

TOWN OF LEXINGTON — BOARD OF PUBLIC WORKS
SEWER DIVISION

Sketch of Service Here

7

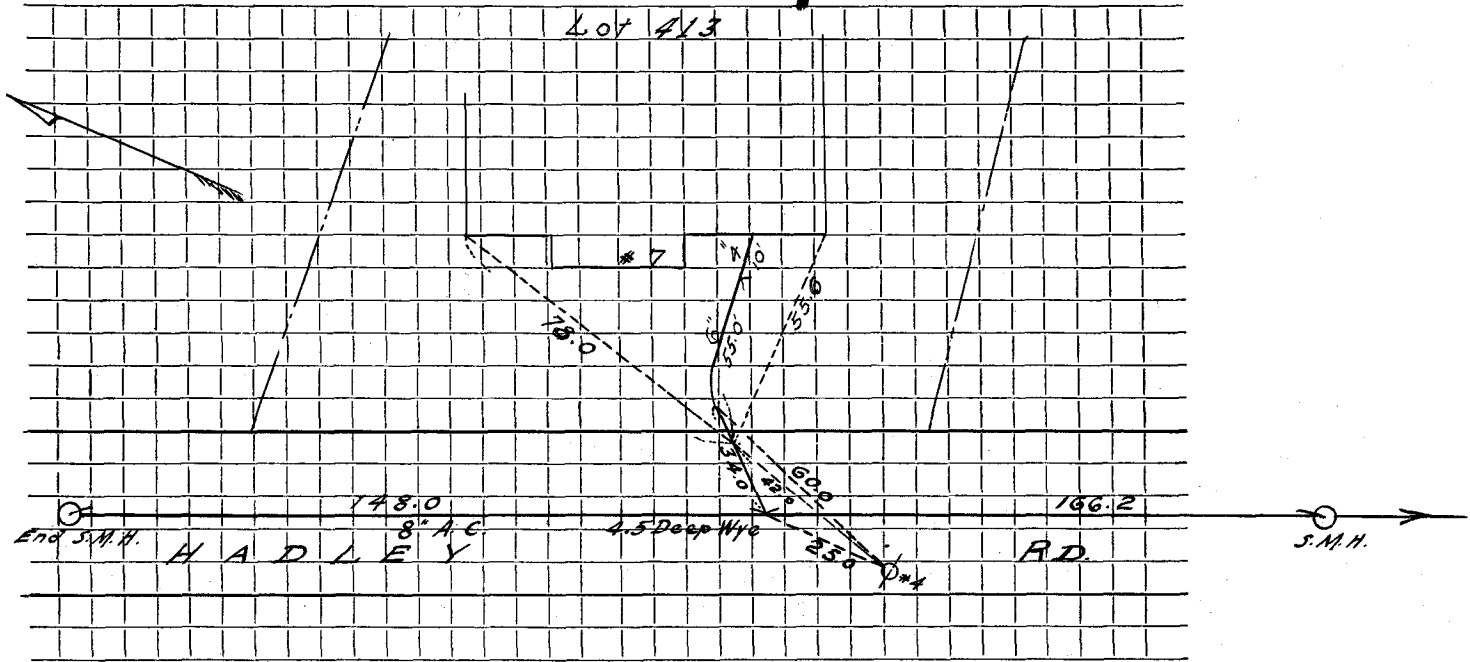

Connection made in Street. Work completed

Remarks:
.....
.....