

Service No.

Name Harold C. Wilson

Address 9 Hadley Road

Lot# 412 Sta. 6+58R

Kind of Pipe Lucente Permit #456

Size

Size of Main

Location

Repair—Renewal—New Service Lexington Sewerage - #616

Location

Date	Material	Amount	Total	Date	Amount
8-25-65	351' 6" Transit pipe				
6/15/67	44' 6" Transit Pipe				
10'	4" Cast Iron			8-25-65	
				35' 6" Transit site	


DATE _____

TOWN OF LEXINGTON — BOARD OF PUBLIC WORKS

SEWER DIVISION

Sketch of Service Here

9

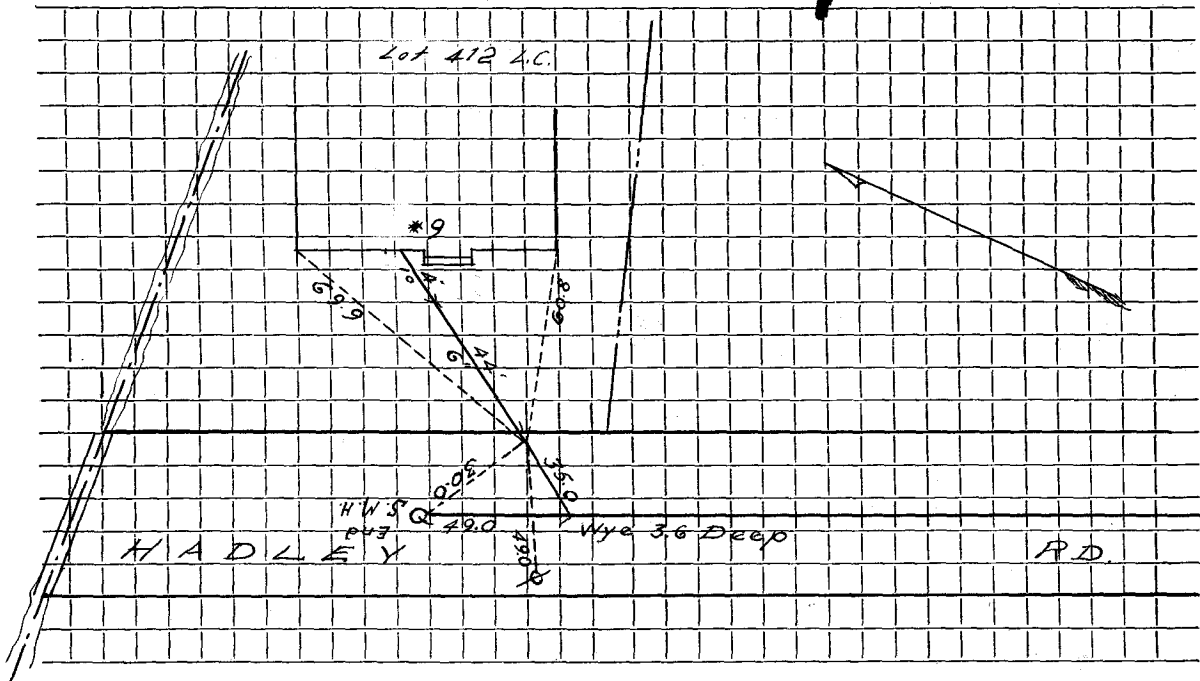

Connection made in Street. Work completed

Remarks:
.....
.....