

Name James C. Shea

Service No. 229

Address 11 Hamblen Street

Location

Kind of Pipe

Size

Size of Main

REPAIRS TO MAIN—New Service

Location

Corner 28-8-0


Date	Material	Amount	Total	Date	Location	Amount
11-21-59	Labor	12 41		11-12-59	Deposit	200 00
11-17-59	"	55 58		2-9-60	Returned	17 91
		67 99				182 09
	10% O. H.	6 80	74 79			
85'	6" Transit pipe @.70		59 50			
4	Hrs. Trucking @.75		3 00			
5	Hrs. Pippin shovel @4.50		22 50			
1	Cesspool cover & frame		10 50			
1	11 1/2" Transit bend		5 10			
100	Sewer brick		4 20			
1	Bag cement		1 50			
1	Ton sand		1 00			
			182 09			

DATE _____

TOWN OF LEXINGTON — BOARD OF PUBLIC WORKS
SEWER DIVISION

Sketch of Service Here

11

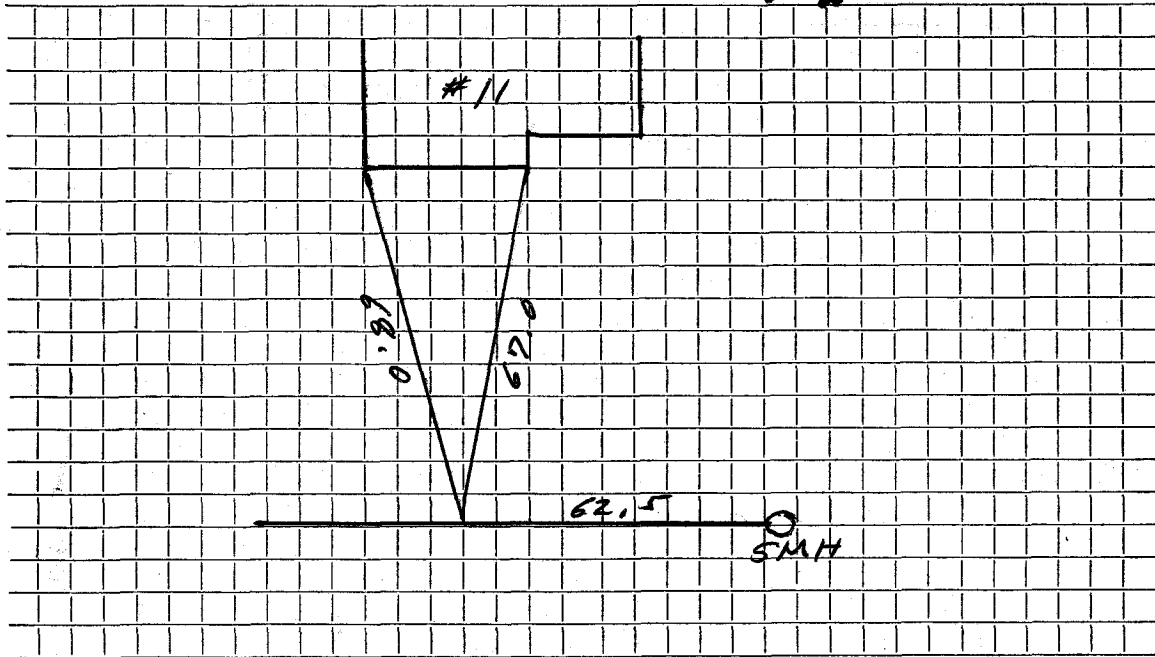

Connection made in Street. Work completed

Remarks:
.....
.....