

Name

Service No.

Address 18 Hambleton Rd

Location

Kind of Pipe

Size

Size of Main

Repair—Renewal—New Service


Location

Date	Material	Amount	Total	Date	Amount
7.25.57	74' - 6" sewer pipe 1 - 45° AC Elbow			1-10-00	50' from house Homeowner problem
12.5.00	Repair made to service 9' - 6" PVC pipe 2 - 6x6 PVC to AC FERRUCOS			12.31-94	Roots 60' Respond + measure

DATE _____

TOWN OF LEXINGTON — BOARD OF PUBLIC WORKS
SEWER DIVISION

Sketch of Service Here

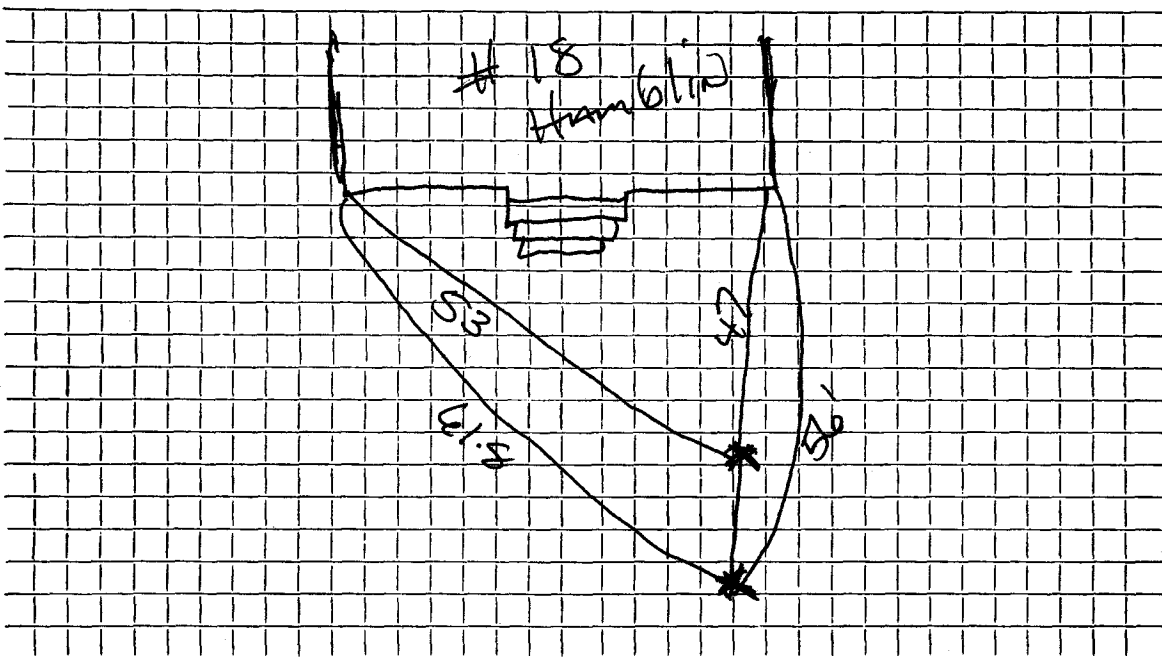

Connection made in Street. Work completed

Remarks: *Repair made 12:5:00 water service to*
left facing house