

Name Charles Robinson

Service No. 190

Address 23 Hamblen Street

Location

Kind of Pipe

Size

Size of Main

~~REPAIR~~ New Service

Location *Comp 12-14-59*


Date	Material	Amount	Total	Date	Amount
10-7-59	Labor	18.92		<i>9-21-59</i>	<i>130.00</i>
10-8-59	"	73.07		<i>9-23-60</i>	<i>33.53</i>
	10% O.H.	9.20	101.19		<i>185.53</i>
	60' 6" Transite pipe @.70		42.00		
1	11 1/2 Transite Bend		5.10		
1	22 1/2 Transite Elbow		2.24		
4	hrs. Trucking @.75		3.00		
4	hrs. Town Shovel @6.50		26.00		
1	hr. Trucking @3.00		3.00		
1	hr. Rodgers Trailer @3.00		3.00		
			<u>185.53</u>		
				<i>Bill sent 12-14-59</i>	<i>33.53</i>

DATE _____

TOWN OF LEXINGTON — BOARD OF PUBLIC WORKS

SEWER DIVISION

Sketch of Service Here **23**

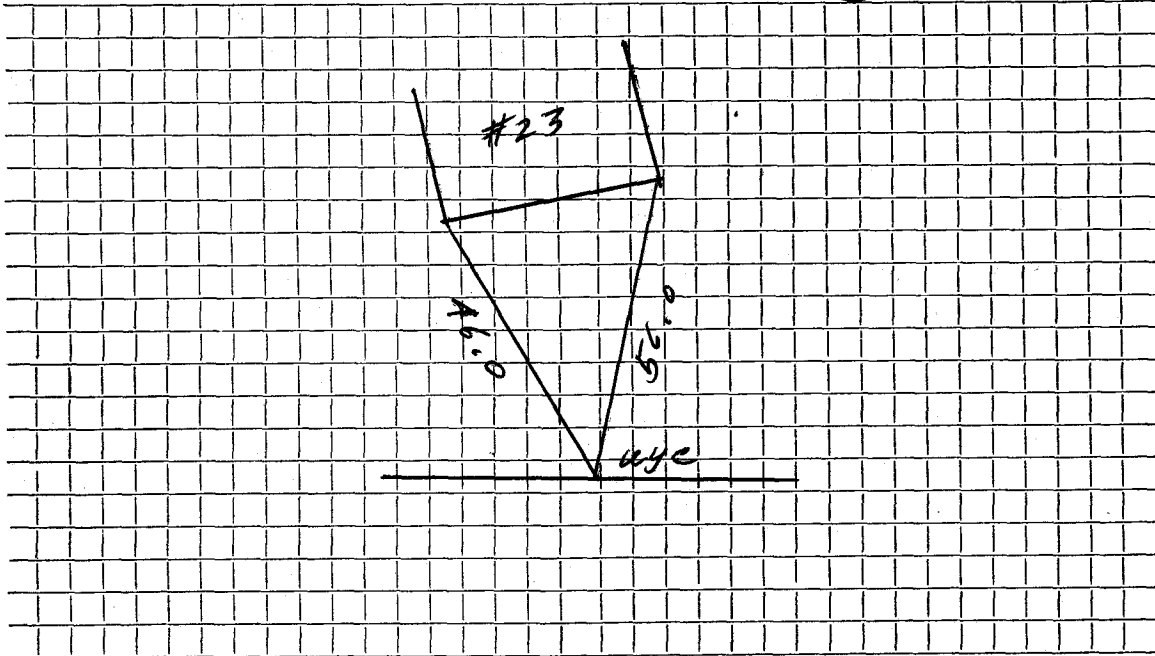

Connection made in Street. Work completed

Remarks:
.....
.....