


DATE 9-27-2001

TOWN OF LEXINGTON — BOARD OF PUBLIC WORKS
SEWER DIVISION

Sketch of Service Here

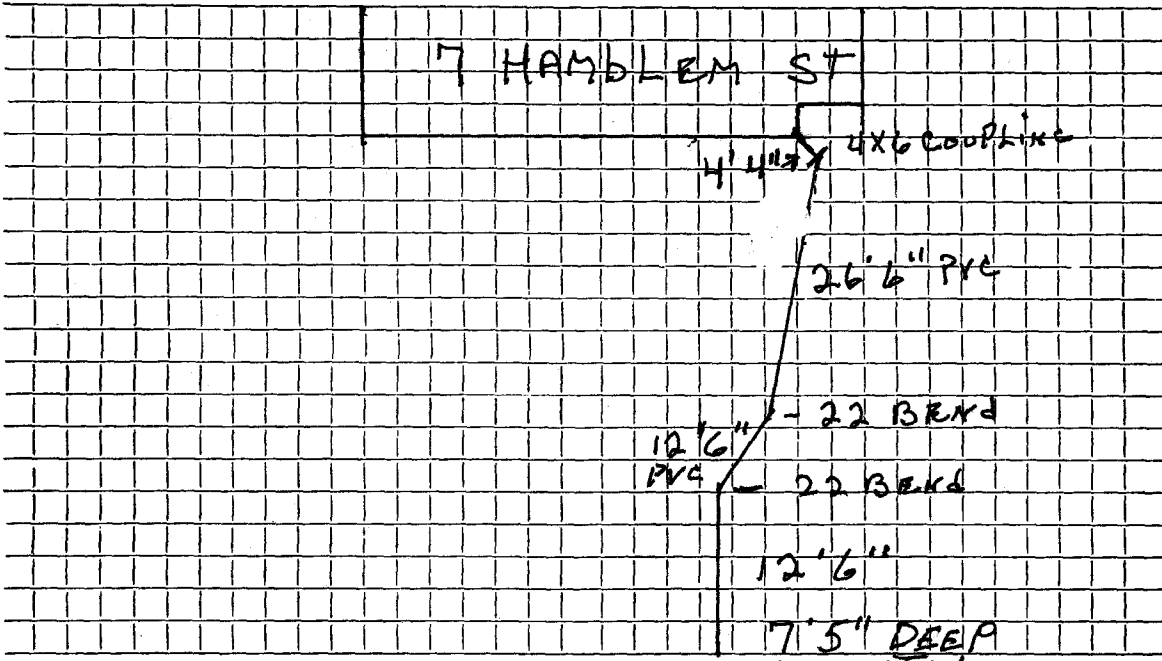

Connection made in HAMBLEN Street. Work completed 9-26-2001

Remarks: INSTALLED BY CHARLES TADD CO.