


DATE _____

TOWN OF LEXINGTON — BOARD OF PUBLIC WORKS
SEWER DIVISION

Sketch of Service Here

18

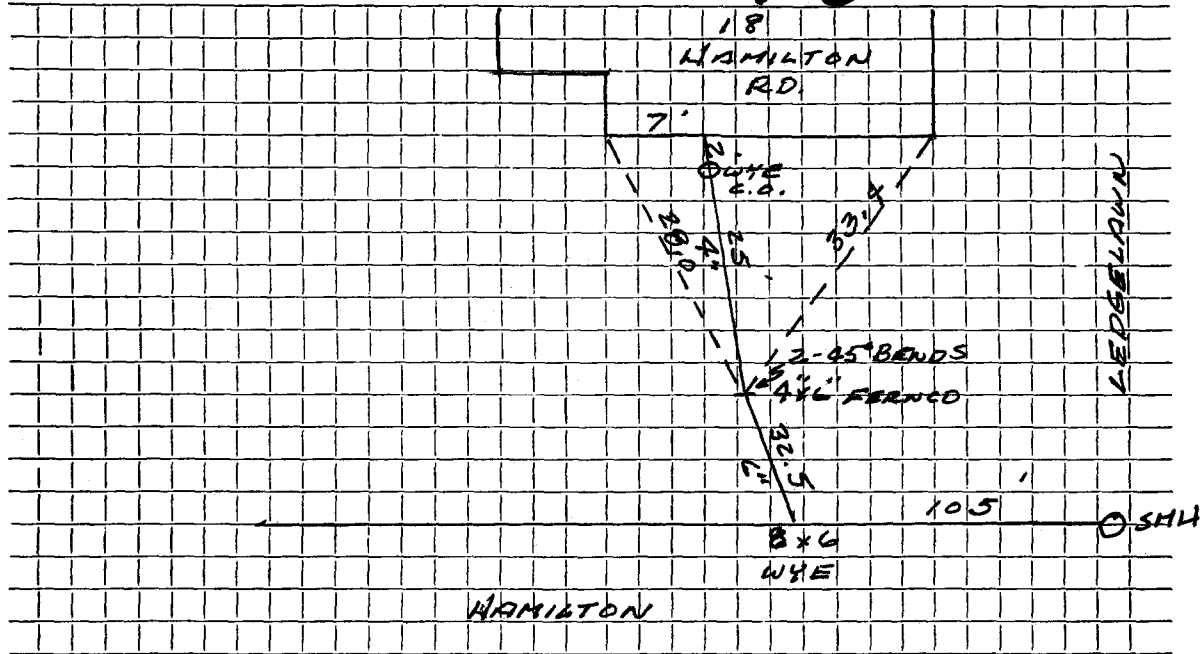

Connection made in HAMILTON RD. Street. Work completed

Remarks: ~~.....~~
.....
.....