

Name Daniel F. Field, Jr.

Service No. 39

Address 21 Hamilton Road

Location 21 Hamilton Road

Lexington

Kind of Pipe Size Size of Main

Repairs: ~~Renewal~~ - New Service *Com. 11-6-50* Location

Date	Material	Amount	Total	Date	Amount
June 22 '50	Labor	39 87		<i>June 14 '50</i>	<i>200 00</i>
" 23 '50	Labor	21 46		<i>June 16 '50</i>	<i>34 26</i>
	10% Overhead	6 13	67 46		<i>165 14</i>
	78' - 6" Sewer Pipe @ 28¢		21 84		
	1 - 6" Elbow		1 56		
	1 - 6" Y		1 60		
	Joint Compound		4 68		
	9½ hrs. Littlefield Shovel @ \$7 66 50		7 66 50		
	2 hrs. Trucking @ 75¢		1 50		
			165 14		
	Labor				

TOWN OF LEXINGTON—DEPT. OF PUBLIC WORKS
SEWER DIVISION

DATE

NO.


The undersigned applies for the construction of a particular sewer connecting No. Street and hereby agrees to comply with the Rules and Regulations governing the construction and use of Particular Sewers, as now or at any future time established by the Board of Selectmen.

Am't of estimate \$.

Am't Paid \$.

..... Owner

Sketch of Service Here

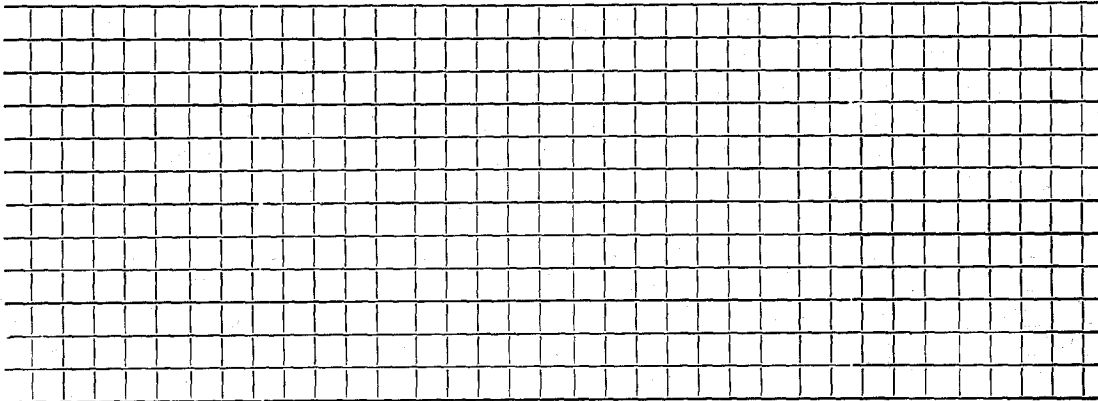

Connection made in Street.

Work completed 19..

Remarks: