

Name

Service No.

Address # 2 HAMPTON RD.

Location Lot 1

Kind of Pipe P.V.C.

Size 6"

Size of Main 8"

Repair—Renewal (New Service)


Location

Date	Material	Amount	Total	Date	Amount
6/12/85	25' of 6" P.V.C.	N/C			
				6-12-85	
				25' 6" P.V.C.	

DATE _____

TOWN OF LEXINGTON — BOARD OF PUBLIC WORKS
SEWER DIVISION

Sketch of Service Here

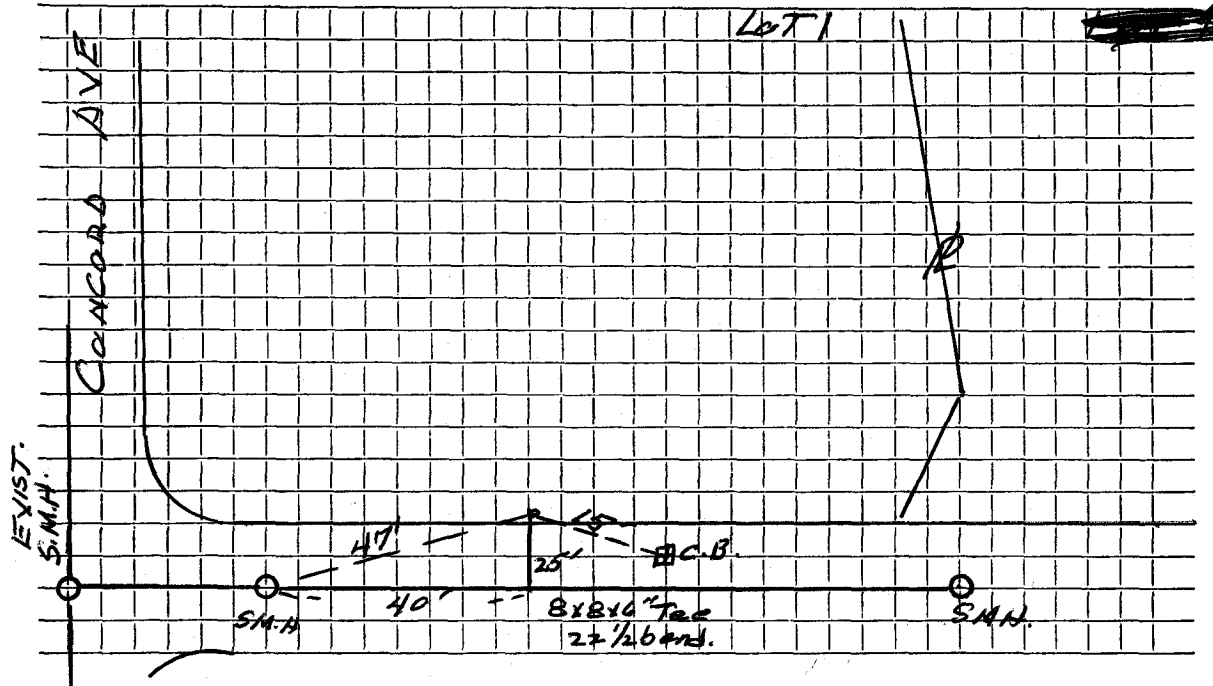

Connection made in Street. Work completed

Remarks:
.....
.....