


09

DATE _____

TOWN OF LEXINGTON — BOARD OF PUBLIC WORKS SEWER DIVISION

Sketch of Service Here

3

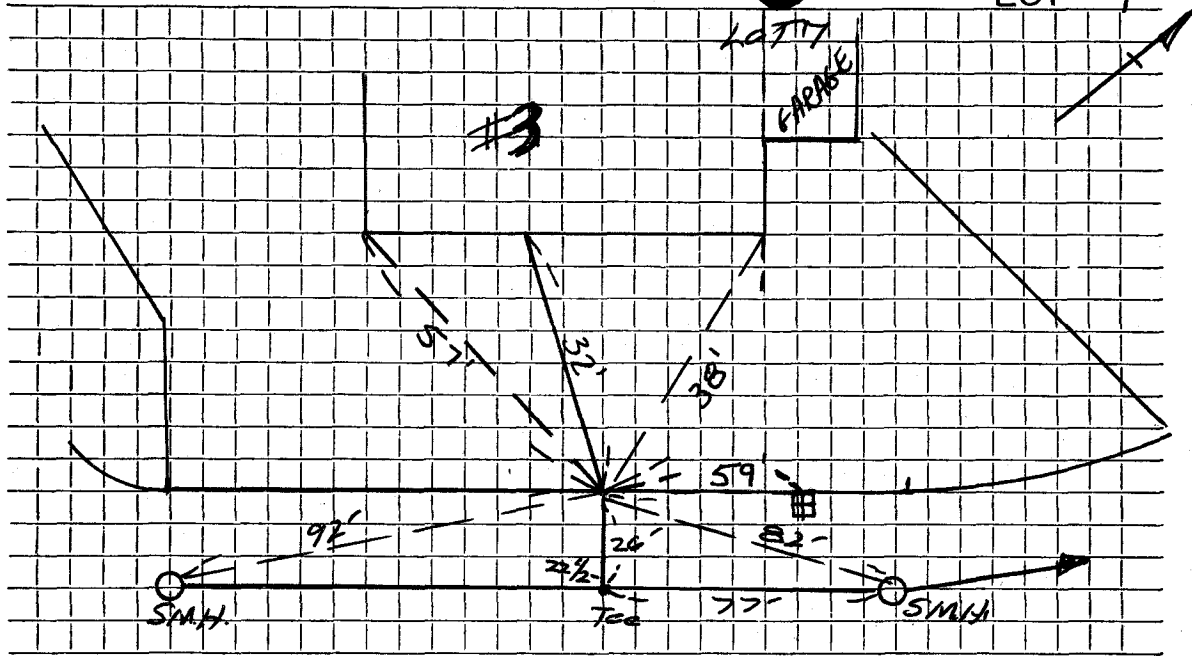

Connection made in HAMPTON RD Street. Work completed

Remarks:
.....
.....