

Name

Service No.

Address 5 Hampton Rd.

Location Lot 6

Kind of Pipe PVC

Size 6"

Size of Main 8"

Repair—Renewal—New Service


Location

Date	Material	Amount	Total	Date	Amount
6/17/85	51' PVC	N/C			
				6-12-85	
				51' 6" P.V.C.	

DATE _____

TOWN OF LEXINGTON — BOARD OF PUBLIC WORKS
SEWER DIVISION

Sketch of Service Here

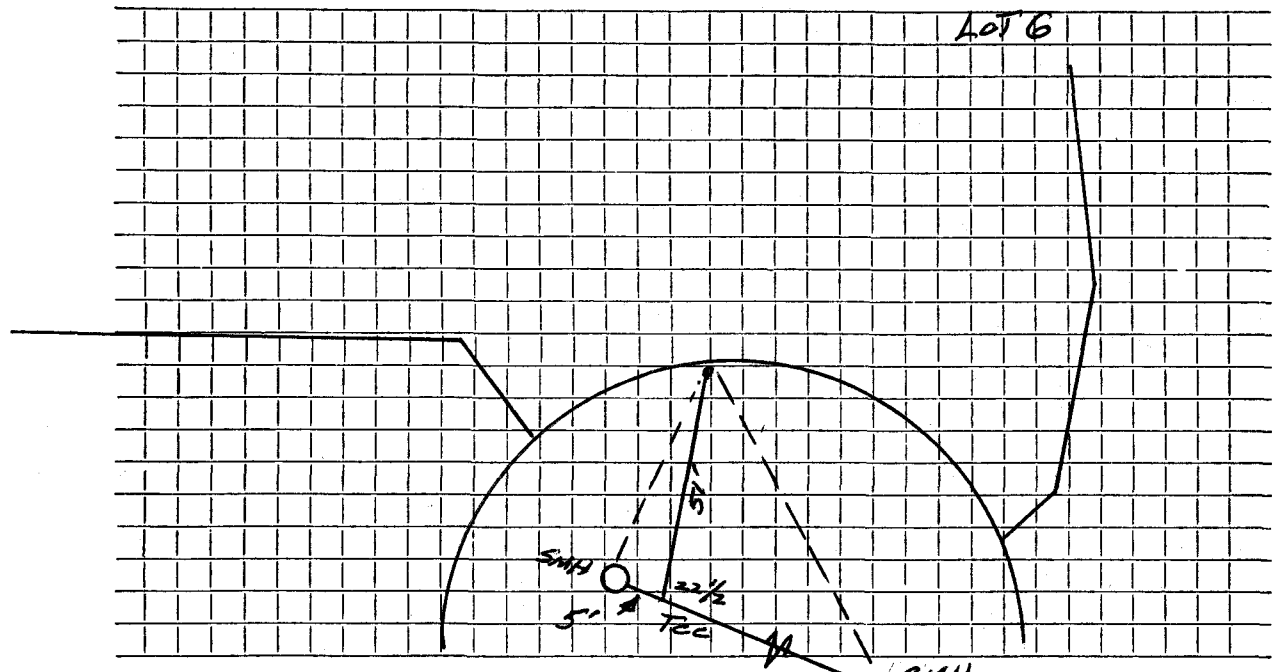

Connection made in Street. Work completed SMH

Remarks:
.....
.....