


DATE _____

TOWN OF LEXINGTON — BOARD OF PUBLIC WORKS

SEWER DIVISION

#7
Sketch of Service Here **7**

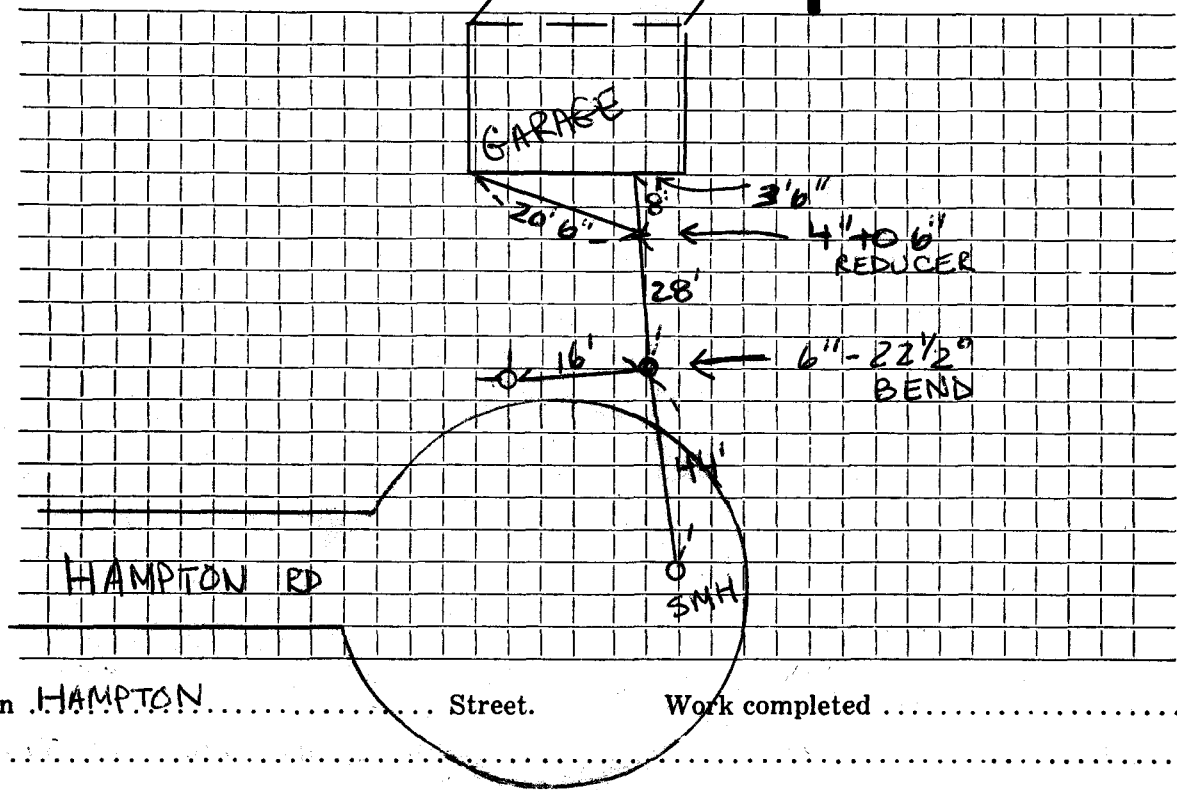

Connection made in HAMPTON Street. Work completed

Remarks:

.....
.....
.....