

ASJ

DATE _____

TOWN OF LEXINGTON — BOARD OF PUBLIC WORKS


SEWER DIVISION

Sketch of Service Here

8

Note

This Service will be on Lot #3 if constructed and will require an easement (REV)

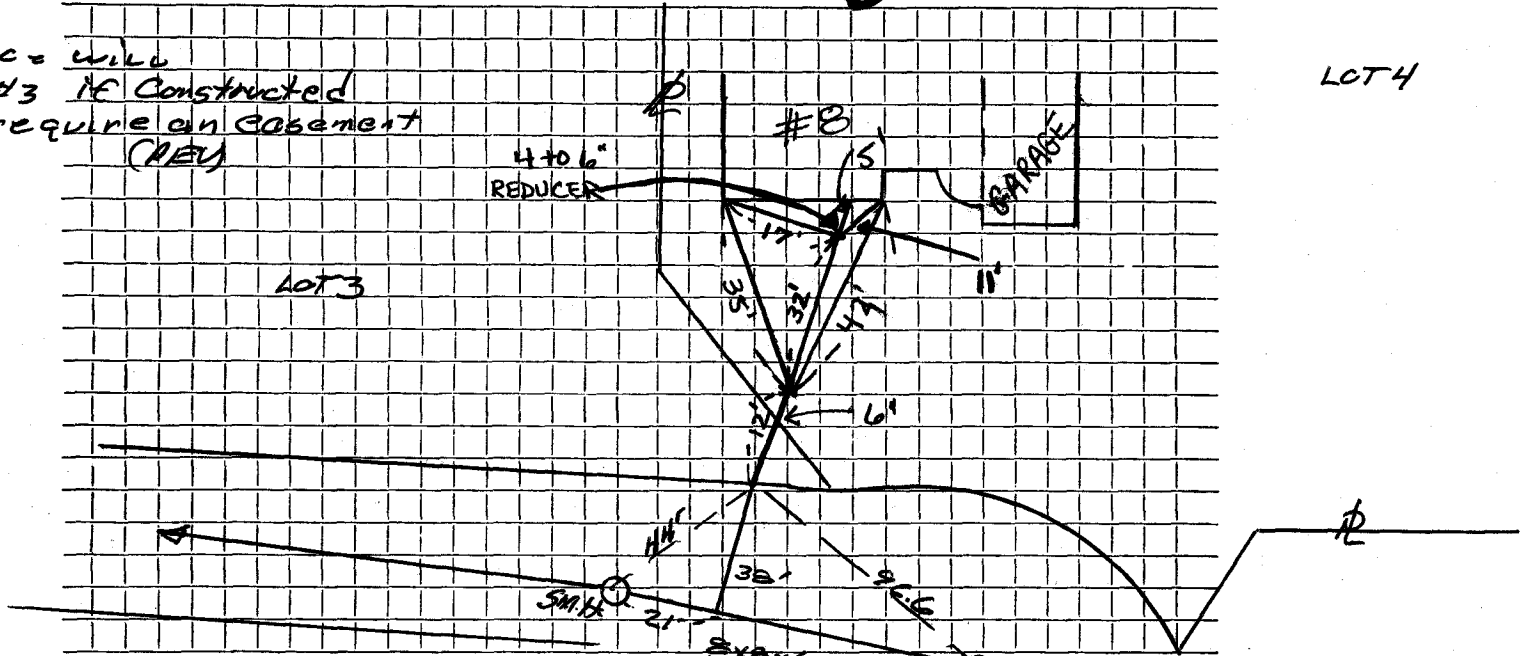

Connection made in HAMPTON RD. Street. Work completed OS.M.H.

Remarks: