

Name Albert R. Carson

Service No. 55 319

Address 12 Hancock Avenue

Location

Kind of Pipe

Size

Revised-Bertrand - New Service

Location

Date	Material	Amount	Total	Date	Amount
25-22-28 for 44.99	27' 6" Clay Pipe @ .30	8 10		Mar. 19 1928 - Cash	44.99
	10' 4" Iron Pipe @ .50	5 00			
	Sulphur & Jute	1 08			
	Trucking	1 25	15 43	Apr. 11 - 15 - 28	
5/17/28 38	Hrs. Labor @ .55	20 90			
8	" " @ .60	4 80	25 70		
	15% Overhead		3 86		
			44 99	1-8-70 - 2 years	
	Labor				

TOWN OF LEXINGTON—BOARD OF PUBLIC WORKS

SEWER DIVISION

DATE May 15, 1928

NO. _____


The undersigned applies for the construction of a particular sewer connecting No. 12 Hancock Ave Street and hereby agrees to comply with the Rules and Regulations governing the construction and use of Particular Sewers, as now or at any future time established by the Board of Selectmen.

Am't. of Estimate \$ _____

Am't. Paid \$ _____

A. J. Benson Owner

Sketch of Service Here

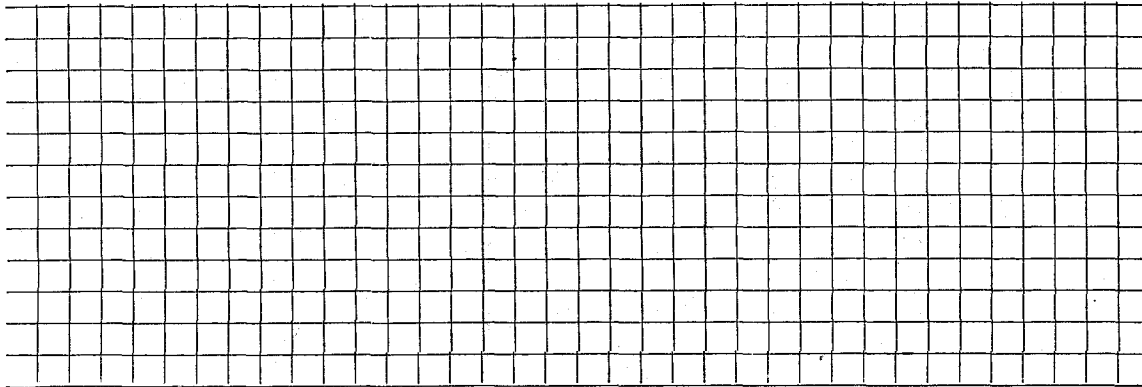

Connection made in _____ Street.

Work completed _____ 19

Remarks: