

Name

Service No. 2514

Address 3 HANCOCKS AVE

Location

LOT 36

Kind of Pipe PVC

Size 6"

Size of Main 6" Clay

Repair—Renewal—New Service

J. Mc L.


Location

Date	Material	Amount	Total	Date	Amount
75'	6" PVC				
6'	4" PVC				
1-	6" New Sewer Saddle				
1	4 X 6 FENCO				

DATE _____

TOWN OF LEXINGTON — BOARD OF PUBLIC WORKS
SEWER DIVISION

Sketch of Service Here

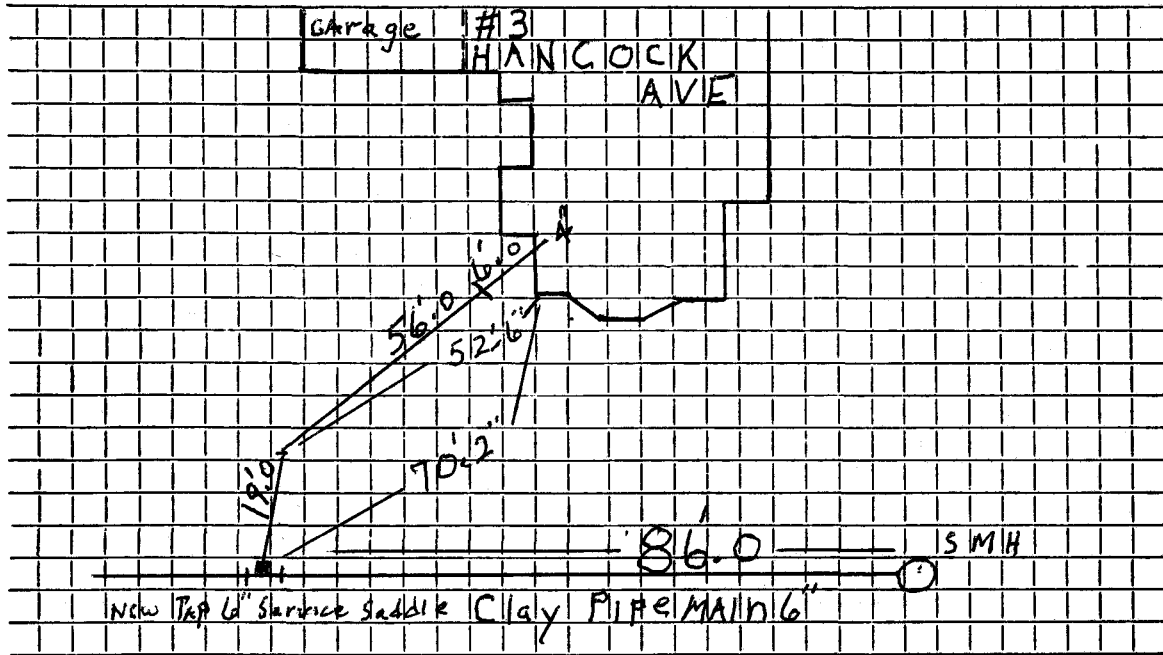

Connection made in Street. Work completed 7/25/07

Remarks: Plant Show 8" @ CAMELLIA PL. Near bedford ST
Iron
.....
.....