

Name

Thomas Holzbog

Address

5 Hancock Avenue

Location

Kind of Pipe

Size

Size of Main

Location

NO CHARGE

W. O. # 219

Repair—Renewal—~~New Service~~

Date	Material	Amount	Total	Date	NO CHARGE	Amount
10-26-72	Labor	49 08		10-26-72	Labor	78 92
10-27-72	"	22 77		10-27-72	"	41 53
10%	O.H.	7 19	79 04			
46'	5" Transite pipe .80		36.80	15'	5" Transite .80	12 00
1	1 1/2" Flow		3 64	1	5" 1 1/2" Elbow	3 44
2	O Ring		7 00	1/2	Bag cement 1.98	50
10	Yds. Loam 3.50		3 50	2	Ton Hot top 7.95	15 90
2	Lbs. seed		6 00	1/2	Hr. Compressorm 5.00	2 50
2	Hrs. Trucking 3.00		6 00	1/2	Hr. Loader 4.00	2 00
	Hrs. Shovel 6.50		13 00	1 1/2	Hrs. Trucking 3.00	4 50
					Roller	2 00
			151 83			163 29


46
15
61

DATE _____

TOWN OF LEXINGTON — BOARD OF PUBLIC WORKS

SEWER DIVISION

Sketch of Service Here

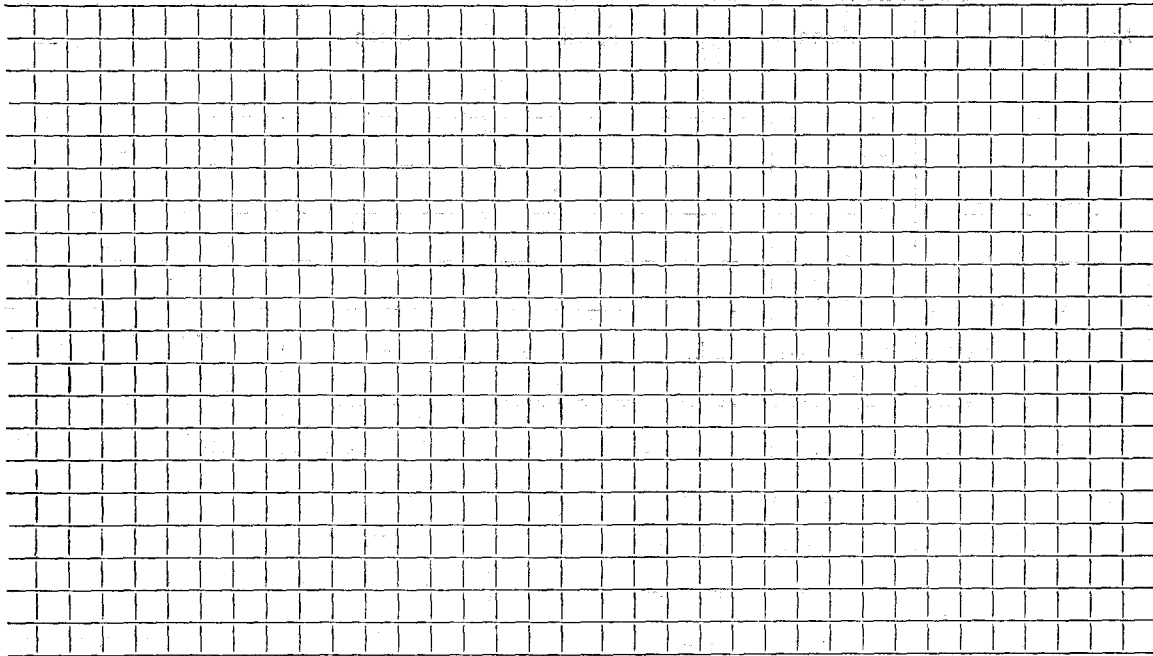

Connection made in Street. Work completed

Remarks:
.....
.....