




DATE 8/1/90  
P.A.B

TOWN OF LEXINGTON — BOARD OF PUBLIC WORKS  
SEWER DIVISION

Sketch of Service Here **6**

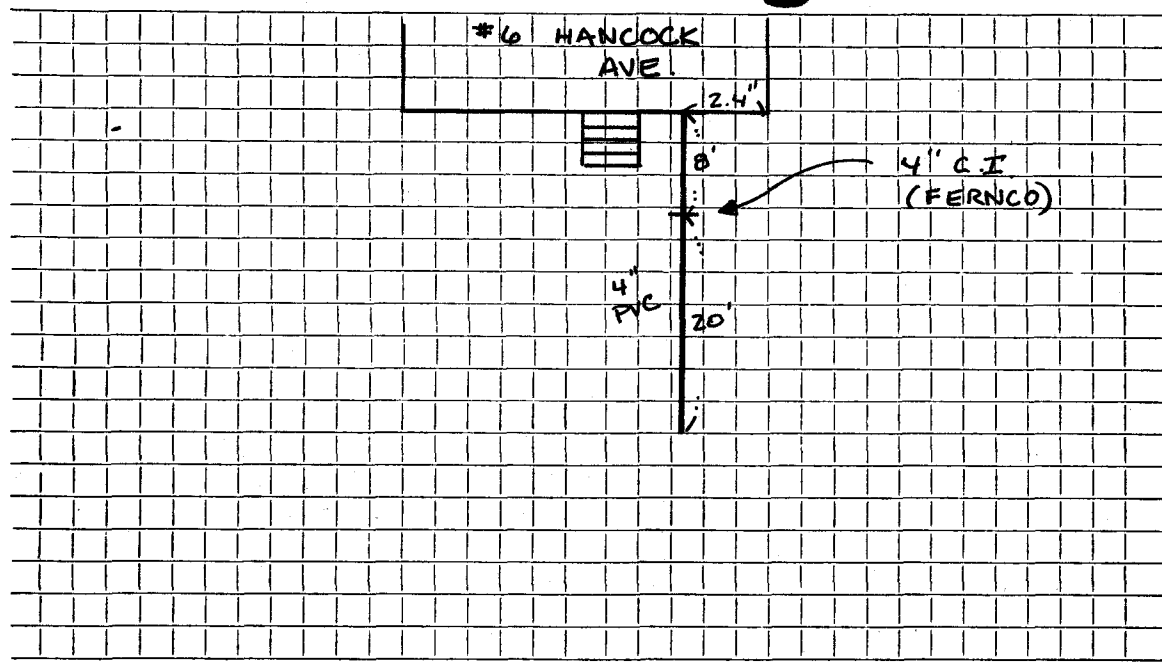

Connection made in ..... HANCOCK ..... AVE. Street. Work completed .....

Remarks: .. INSPECTED: P. A. BARROWS .....

..... CONTRACTOR: BRUCE McKee .....

Original card 1927