

Name Mrs. Lillian G. Jones

Service No. 11 3/6

Address 8 Hancock Ave.

Location

Kind of Pipe Size of Main

Repair-Renewal-New Service

Location

Date	Material	Amount	Total	Date	Amount
<i>Nov. 27 52.74</i>	1 Stick Dynamite	25			
<i>5-4-31</i>	2 Caps @ .14	28			
	52' 6" Sewer Pipe @.25	13 00			
	10' 4" Iron " @.50	5 00			
	Sulphur & Jute	2 08			
	Trucking	<u>1 75</u>	22 36		
	Use of compressor		5 00		
<i>11/31</i>	69 Hrs. Labor @.55	37 95			
	17 " " @.60	<u>10 20</u>	48 15		
	15% Overhead		<u>7 023</u>		
	Labor.		<u>82 74</u>		

*July 17 1931 - Cash 82 74*

TOWN OF LEXINGTON—BOARD OF PUBLIC WORKS

**SEWER DIVISION**

DATE June 24<sup>th</sup> 1931

NO. \_\_\_\_\_


The undersigned applies for the construction of a particular sewer connecting No. 8 Hancock Ave  
Street and hereby agrees to comply with the Rules and Regulations governing the construction and use of Particular  
Sewers, as now or at any future time established by the Board of Selectmen.

Am't. of Estimate \$ \_\_\_\_\_

Am't. Paid \$ \_\_\_\_\_

William B Jones, Owner

Sketch of Service Here

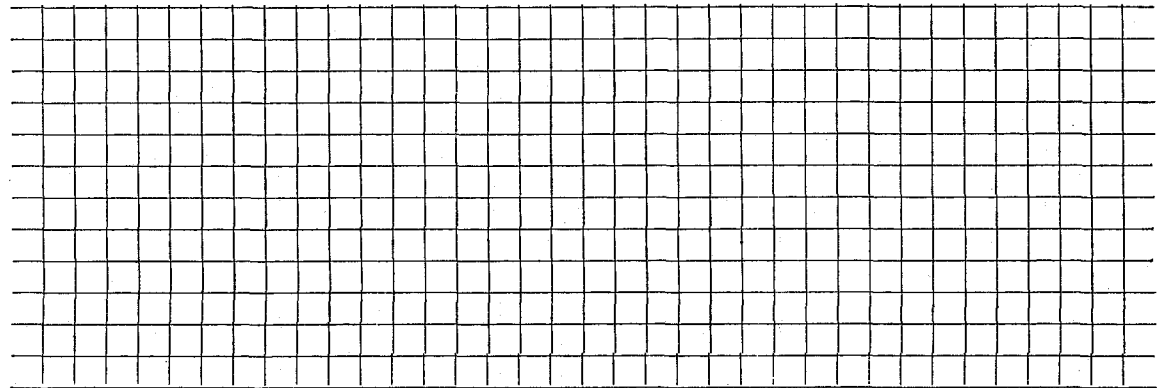

Connection made in \_\_\_\_\_ Street.

Work completed \_\_\_\_\_ 19

Remarks: