

Name

Service No.

Address

11 HANCOCK STREET

Location

Kind of Pipe

Size

Size of Main

Repair—Renewal—New Service

Location


Date	Material	Amount	Total	Date	Amount
2-19-27					
18'	4" Soil Pipe				
32'	4" Sewer Pipe				
1	6" X 10" Wye				
1	6" Bend				

TOWN OF LEXINGTON — BOARD OF PUBLIC WORKS

SEWER DIVISION

DATE _____

Sketch of Service Here

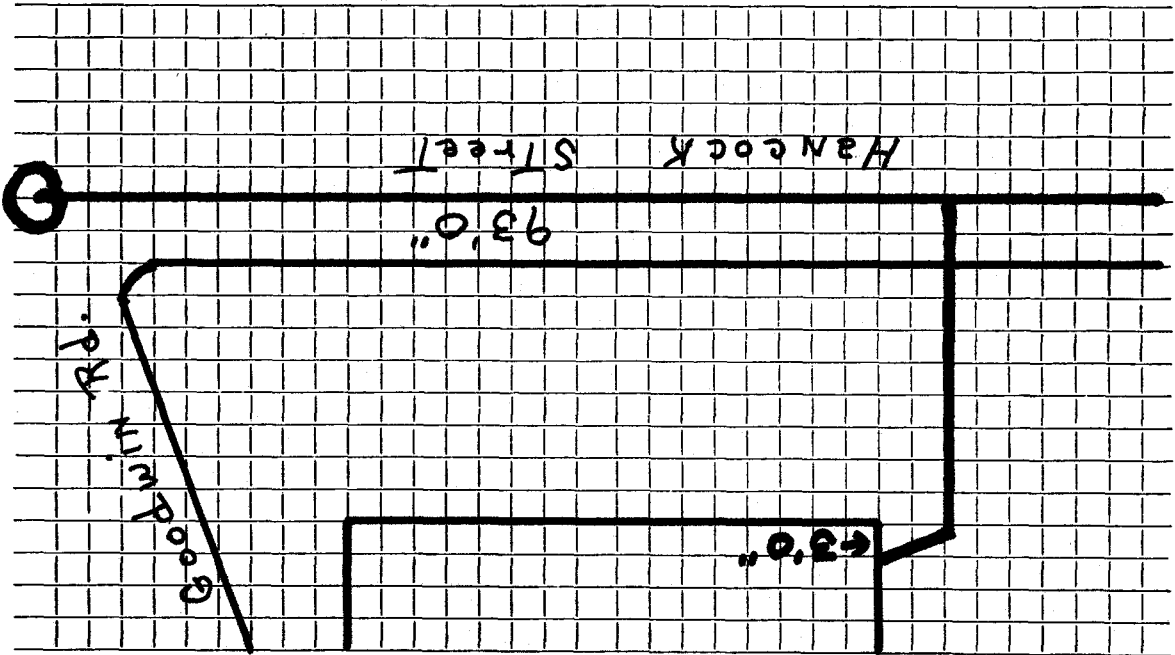

Work completed

Street.

Connection made in

Remarks: