




TOWN OF LEXINGTON — BOARD OF PUBLIC WORKS

SEWER DIVISION

DATE \_\_\_\_\_

12

Sketch of Service Here

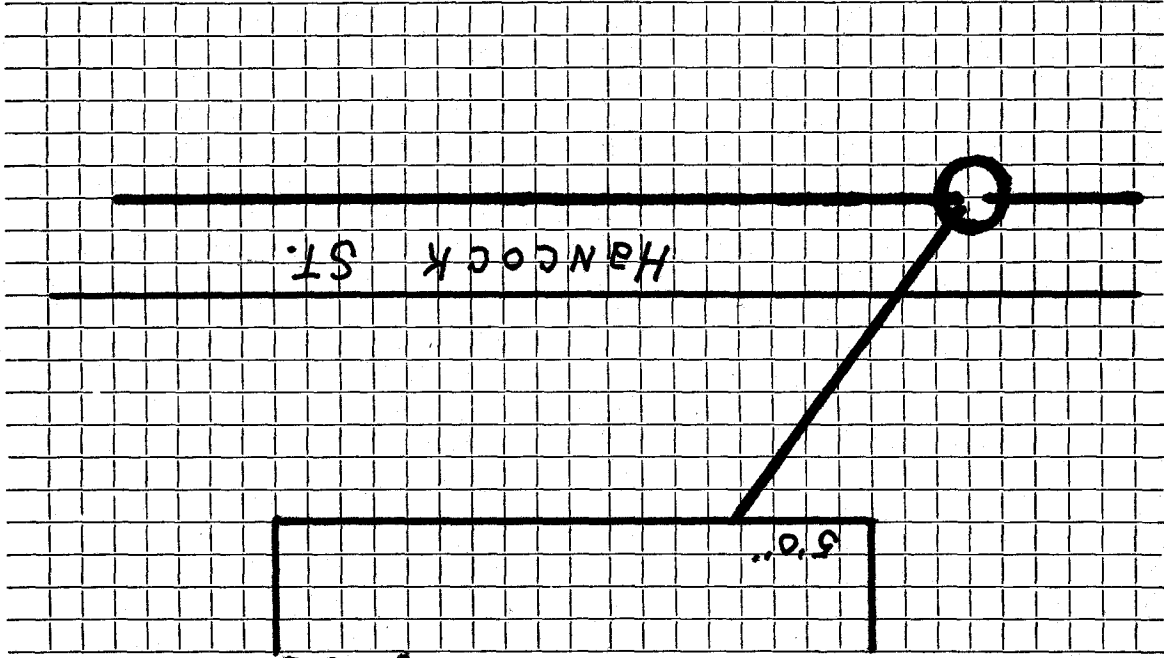

Work completed

Street.

Remarks: Original Service 2-15-27

Connection made in