




TOWN OF LEXINGTON — BOARD OF PUBLIC WORKS  
DATE \_\_\_\_\_

SEWER DIVISION

Sketch of Service Here

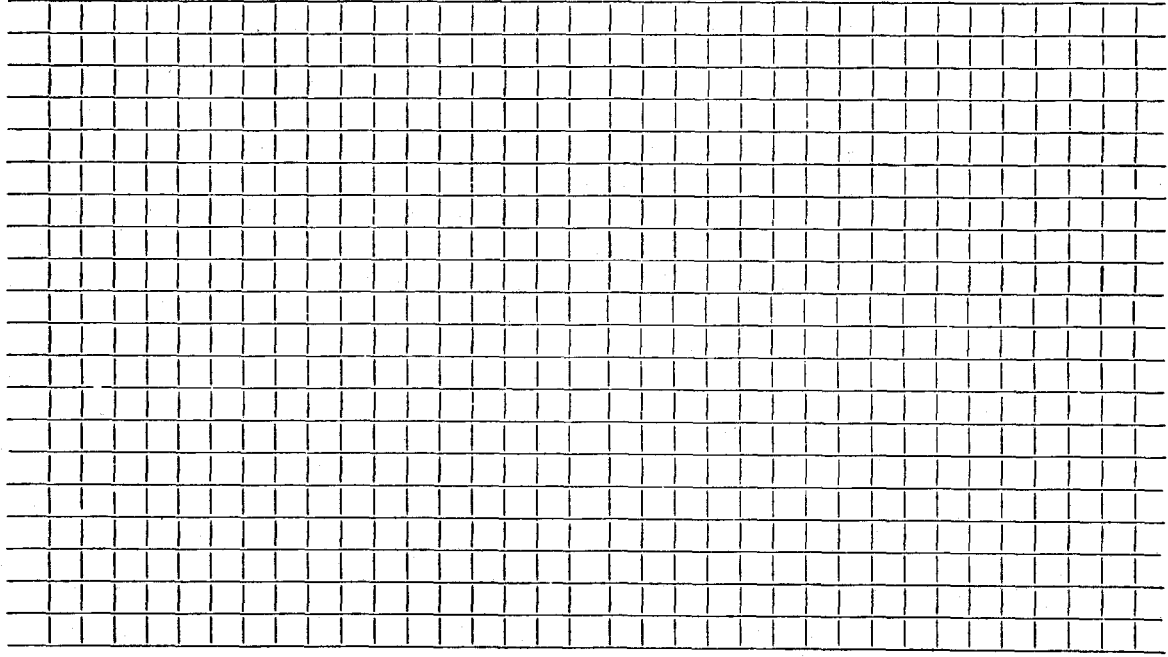


A large grid for sketching service here, consisting of 20 columns and 20 rows.

Work completed

Street.

Connection made in

Remarks:

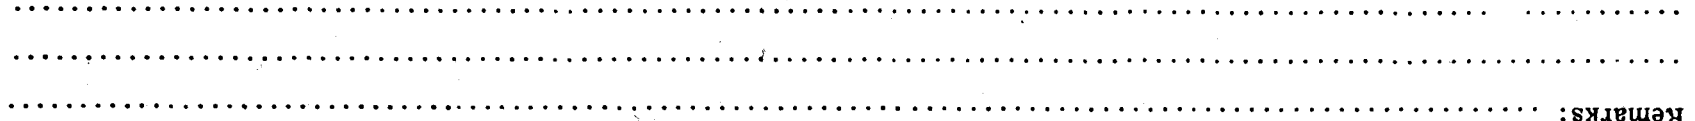

Four horizontal dotted lines for handwritten notes.