


TOWN OF LEXINGTON — BOARD OF PUBLIC WORKS

SEWER DIVISION

DATE _____

16

Sketch of Service Here

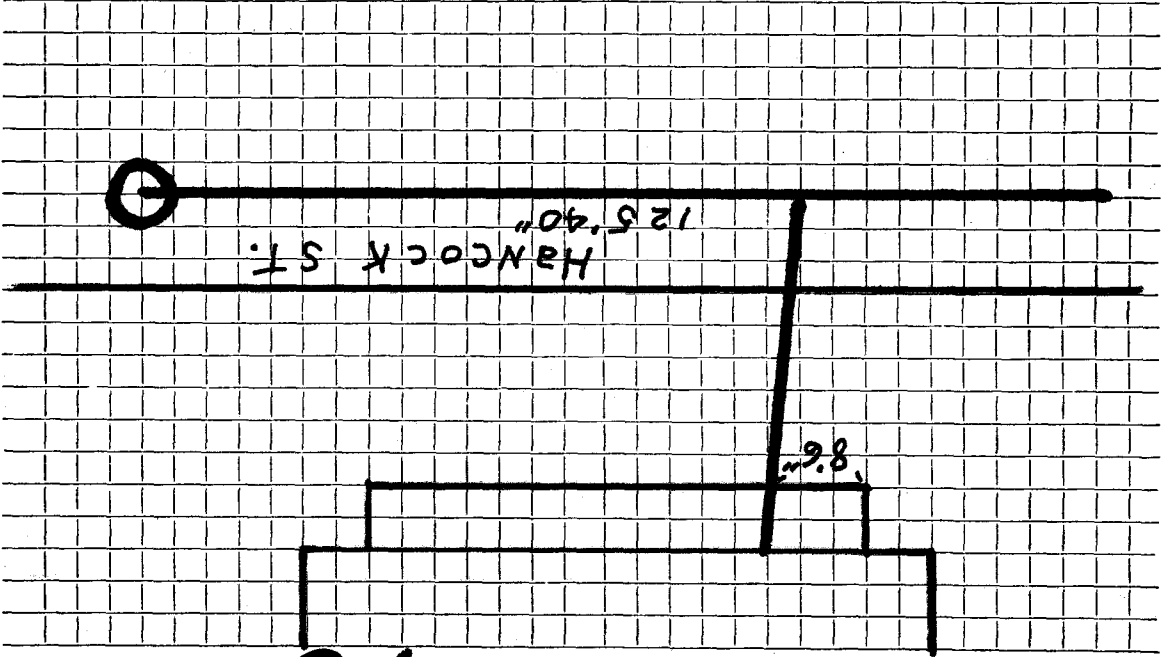

Work completed

Street.

Connection made in

Remarks:

DATE _____

TOWN OF LEXINGTON — BOARD OF PUBLIC WORKS

SEWER DIVISION

Sketch of Service Here

A large rectangular area filled with a grid of small squares, intended for drawing a sketch of service connections. The grid consists of approximately 20 columns and 20 rows.

Work completed

Street

Connection made in

Remarks: