

TOWN OF LEXINGTON—BOARD OF PUBLIC WORKS

SEWER DIVISION

DATE _____

NO. 18

The undersigned applies for the construction of a particular sewer connecting No. 18 Hancock St

Street and hereby agrees to comply with the Rules and Regulations governing the construction and use of Particular Sewers, as now or at any future time established by the Board of Selectmen.


Am't. of Estimate \$ _____

Am't. Paid \$ _____

Thomas Peter Clarke Owner
18 Hancock St

Sketch of Service Here

18

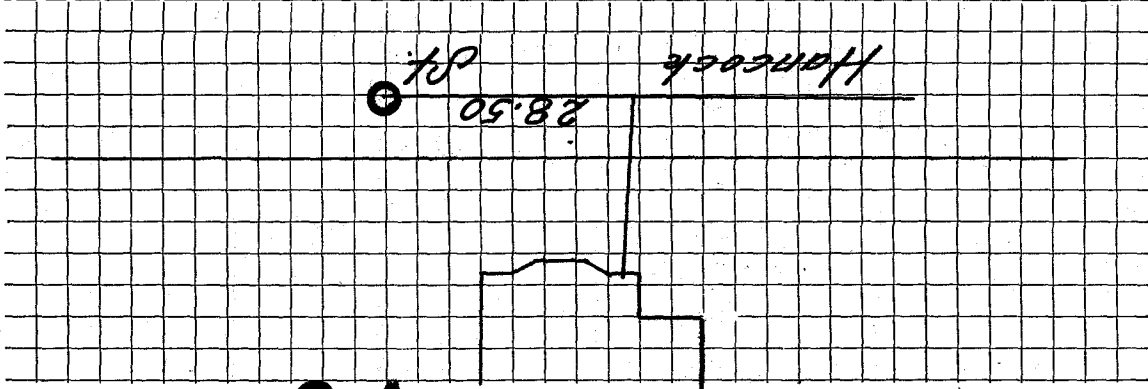

Connection made in _____ Street. Work completed _____ 19

Remarks: Original Service 2-16-27