


TOWN OF LEXINGTON — BOARD OF PUBLIC WORKS

SEWER DIVISION

DATE _____

19

Sketch of Service Here

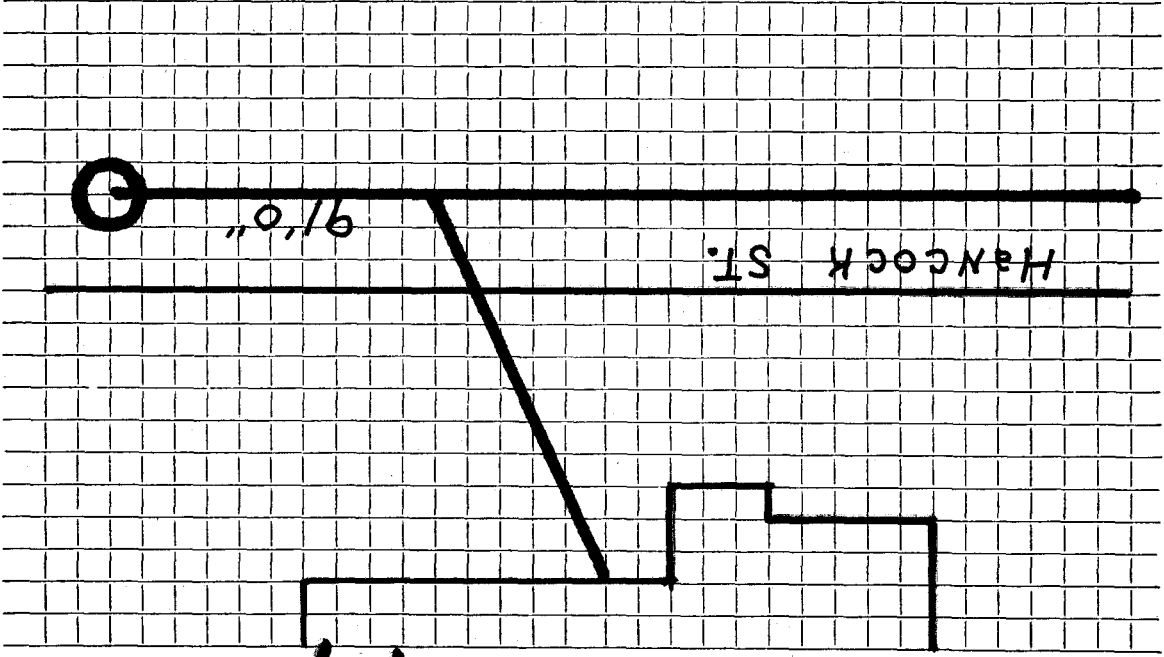

Work completed

Street.

Connection made in

Remarks: