

Name

Address

20 HAWCOCK ST.

Kind of Pipe

Size

Location

Size of Main

Repair—Renewal—New Service

Location


Date	Material	Amount	Total	Date	Amount
1927					

Service No.

SEWER DIVISION

DATE _____

Sketch of Service Here 20

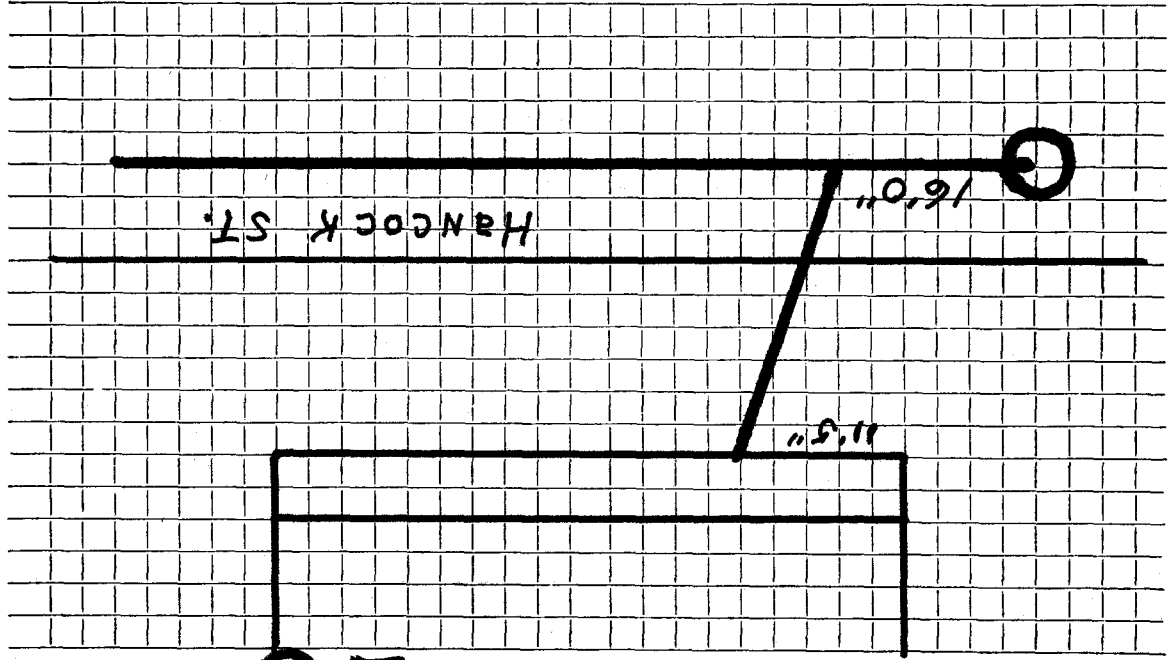

Connection made in _____ Street. Work completed _____

Remarks: _____