

Name Wolcott Realty Co.

Service No. 17 333

Address ~~224~~ Westington St. Boston Rm. 650

23 Hancock St. Location 23 Hancock St., Lexington

Kind of Pipe Size of Main

~~Revised Record~~ New Service Location

Date	Material	Amount	Total	Date	Location	Amount
Aug. 15 <small>99m. 30/10 to small 210/35</small>	18 hrs. Labor @ 55¢	9 90		Aug. 18 1935	Deposited	35 00
	8 " " @ 60¢	4 80		Sept. 17 1935	Refrunded	4 90
	2 " " @ 65¢	1 95				30 10
	10% Ovhd. on Labor	1 67				
	58' 6" Sewer Pipe @ .16	9 28				
	Sulphur & Jute	1 50				
	Trucking	<u>1 00</u>				
			30 10			
	Labor					

TOWN OF LEXINGTON—BOARD OF PUBLIC WORKS

SEWER DIVISION


NO. _____

DATE Aug 14, 1935

The undersigned applies for the construction of a particular sewer connecting No. 23 Hancock Street and hereby agrees to comply with the Rules and Regulations governing the construction and use of Particular Sewers, as now or at any future time established by the Board of Selectmen.

Am't. of Estimate \$ _____
 Am't. Paid \$ _____

Wesley Park Co Engineers
294 Wash St Boston
 Owner

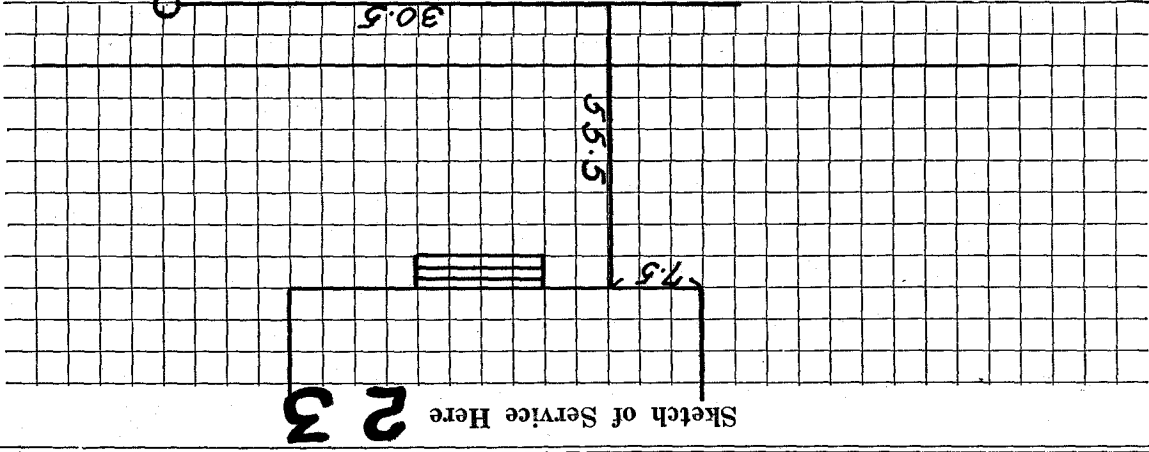

Connection made in _____ Street. Work completed _____ 19

Remarks: