


DATE _____
TOWN OF LEXINGTON — BOARD OF PUBLIC WORKS
SEWER DIVISION

Sketch of Service Here
26

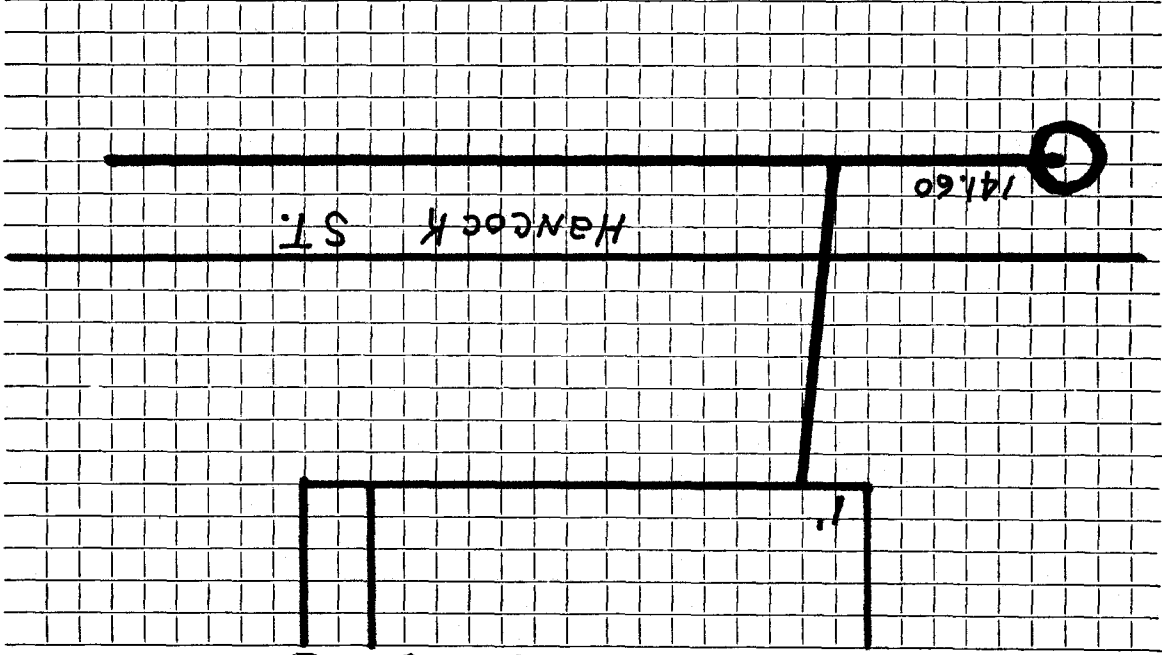

Connection made in Street. Work completed
Remarks: