


TOWN OF LEXINGTON — BOARD OF PUBLIC WORKS

SEWER DIVISION

DATE _____

Sketch of Service Here
27

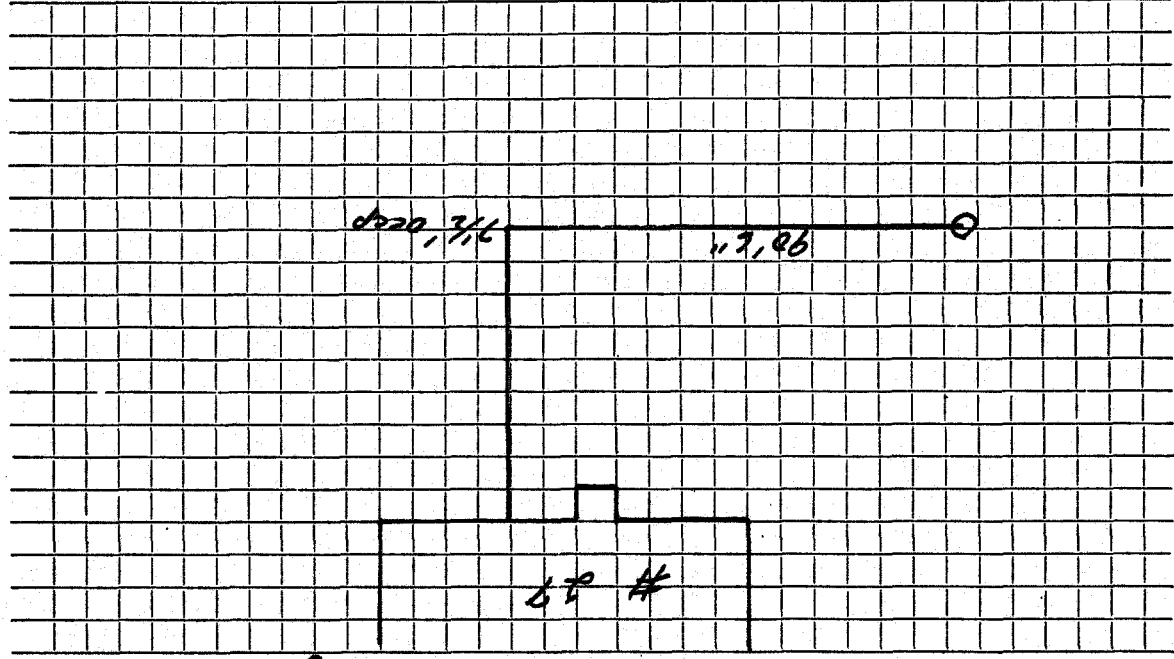

Work completed

Street

Connection made in

Remarks: Original Service 4-6-29