


TOWN OF LEXINGTON — BOARD OF PUBLIC WORKS

SEWER DIVISION

DATE _____

Sketch of Service Here
32

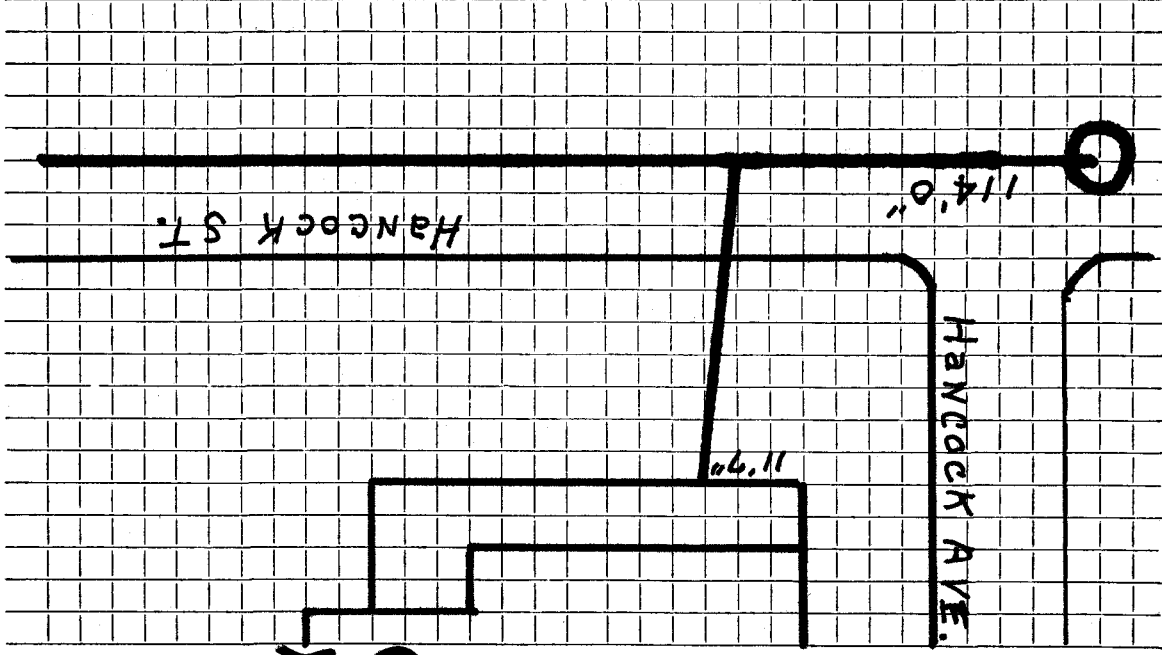

Connection made in _____ Street. Work completed _____

Remarks: _____