

Name Paul Stetson

Service No.

Address 33 Hancock Street

Location

Kind of Pipe Permit #279

Size

Size of Main

Repair ~~Renewal~~ - New Service Lexington Sewerage Co.

Location

Date	Material	Amount	Total	Date	Amount
8-13-65	81' 6" Clay Pipe				


TOWN OF LEXINGTON — BOARD OF PUBLIC WORKS

SEWER DIVISION

DATE _____

Sketch of Service Here

33

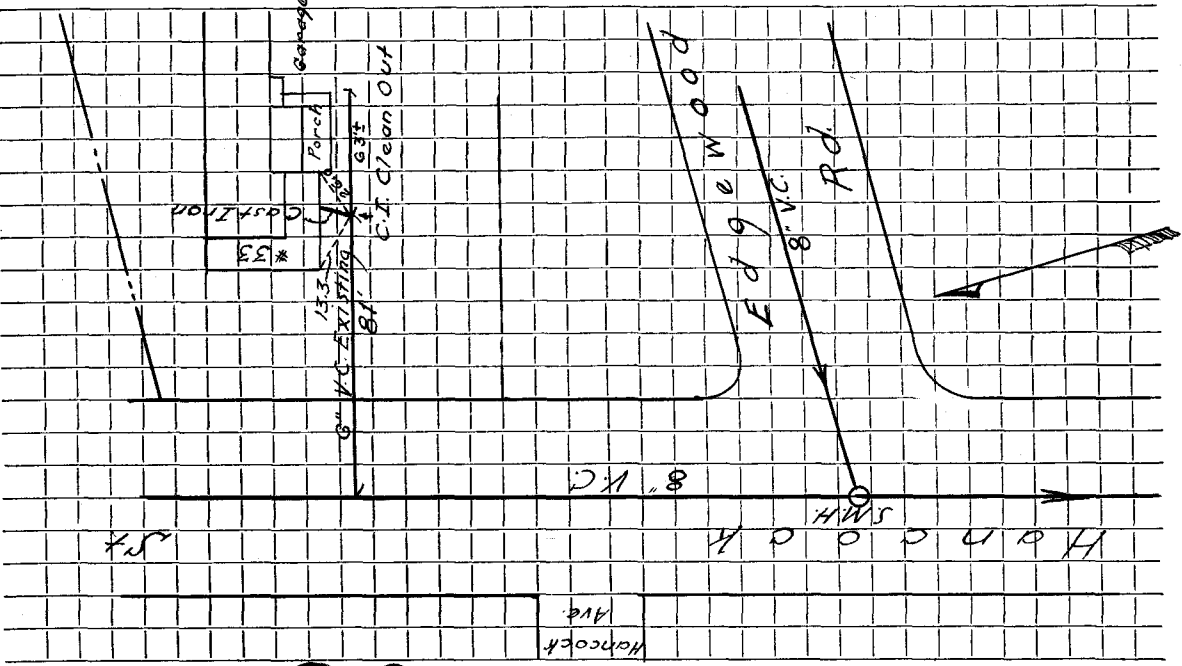

Hancock
Ave

Hancock
8" V.C.

Edge Wood
8" V.C.
Rd

C.T. Clean Out

81'

15.3'

* 33

Gas Line

Garage

Porch

83'

15'

Street.

Work completed

Connection made in
Remarks: Original Service 2-15-27