

Name

Service No.

41 Hancock St

Address ~~35~~ Hancock Street for 25 Somerset Road

Location

Kind of Pipe

Size

Size of Main

Repair—Renewal—New Service

Location


Date	Material	Amount	Total	Date	Amount
1929	120' 4" Sewer Pipe				
	1 1/2" Band				
	1 10 x 6 Y				
	See notes and Jct				
				6/13/14/79	
					OUTSIDE W.O.#0508
					Labor
				2	6" X 10 ft. Trans Pipe
				1	6" X 5' Trans nipple
				1	6" X 1' Trans. nipple
				1	6" X 90 Trans elbow
				1	6" X 8" saddle
					Patch Trench 30' X 8'
					Patch Sidewalk 12' X 7'
				6 1/2	Hrs. Trucking
				4	Hrs. Case
				1 1/2	Hrs. Roller

TOWN OF LEXINGTON — BOARD OF PUBLIC WORKS

SEWER DIVISION

DATE \_\_\_\_\_

Sketch of Service Here

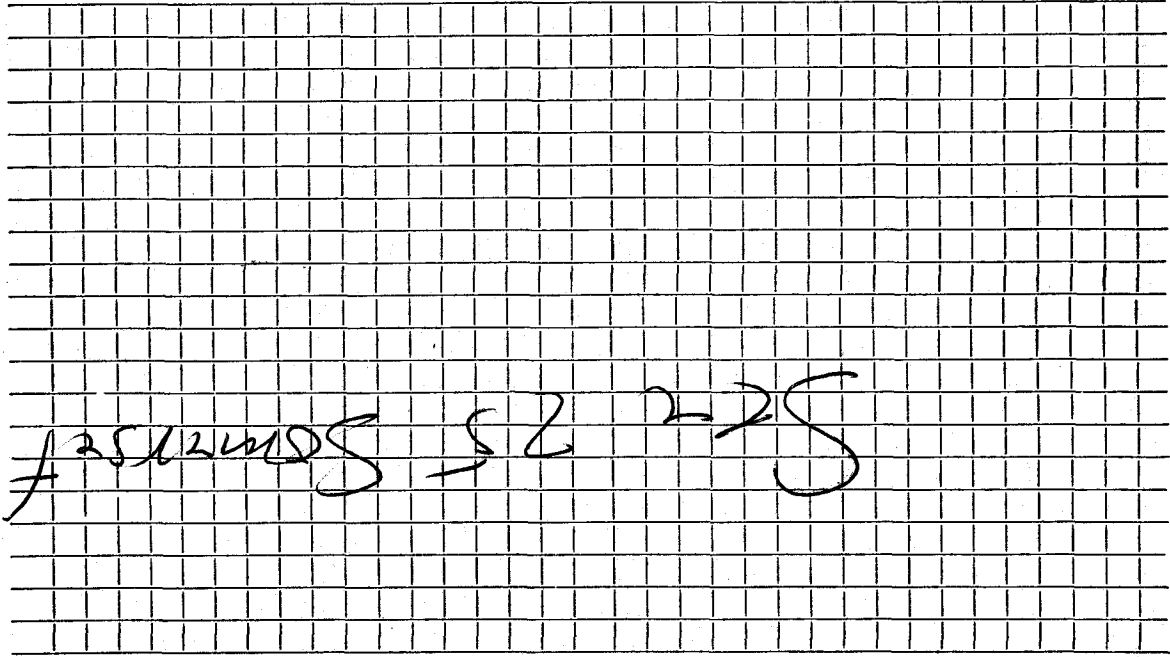

Work completed

Street

Connection made in

Remarks: Original Service 1929