

Name Moore Realty Trust
 Address 44 Hancock Street

Service No. 190

Location

Kind of Pipe DeFlice Bros. Permit #159
~~Repair~~ ~~Renewal~~ - New Service W.O. #9345

Size of Main

Location FEB 15 1965


Date	Material	Amount	Total	Date	Amount
11-27-64	Labor	43.18		11-13-64	Deposit
11-30-64	"	124.26		2-15-65	Paid by W.H.P. #140
	10% O.H.	16.74	184.18	3-1-65	Abolite
20'	6" Transite Pipe @.82		16.40	3-22-65	Paid
1	11 1/4" Transite Bend		4.09		
1	Bag Cement		1.50		
1	13X12 Patch (Street)		52.00		
1	3 X 5 Patch (Sidewalk)		5.00		
8	Hrs. Town Shovel @6.50		52.00		
3	Hrs. Town Truck @3.00		9.00		
			<u>324.17</u>		
12-15-64	37' Transite Pipe				

TOWN OF LEXINGTON — BOARD OF PUBLIC WORKS

SEWER DIVISION

DATE _____

Sketch of Service Here
44

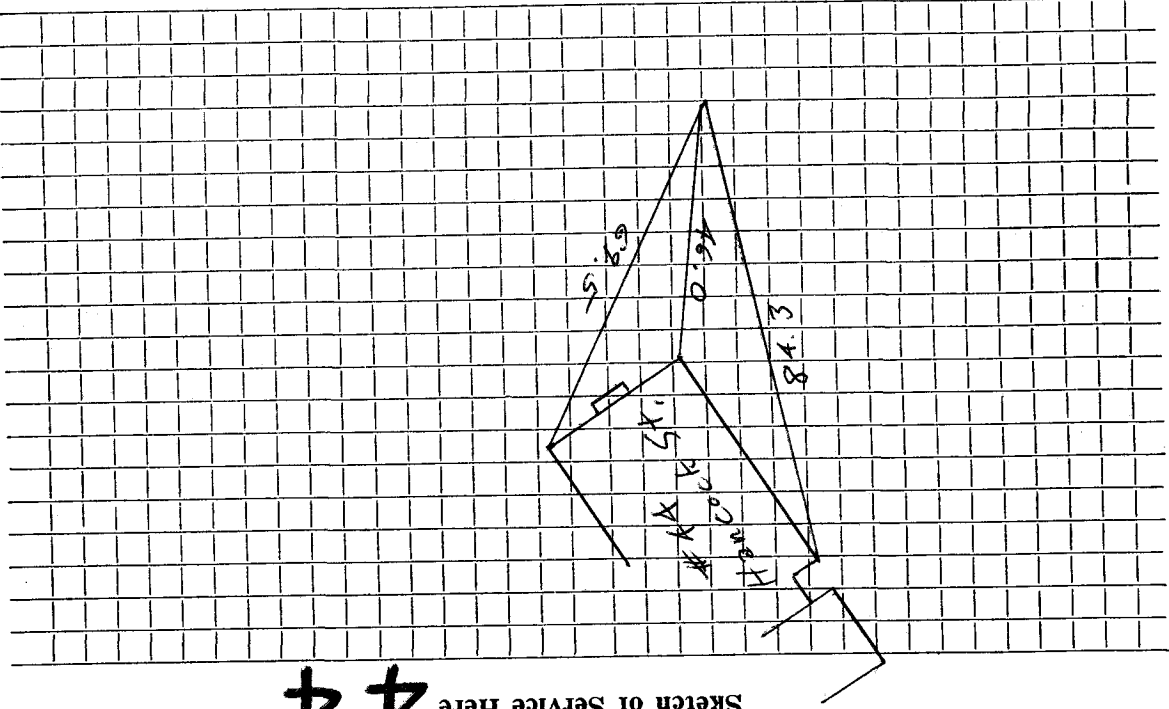

Connection made in Street. Work completed
Remarks: