


Connection made in **HANCOCK** Street. Work completed

Remarks: THIS IS A RECONSTRUCTION DONE BY THE TOWN PUBLIC WORKS DEPT

Original Service 5-2-27

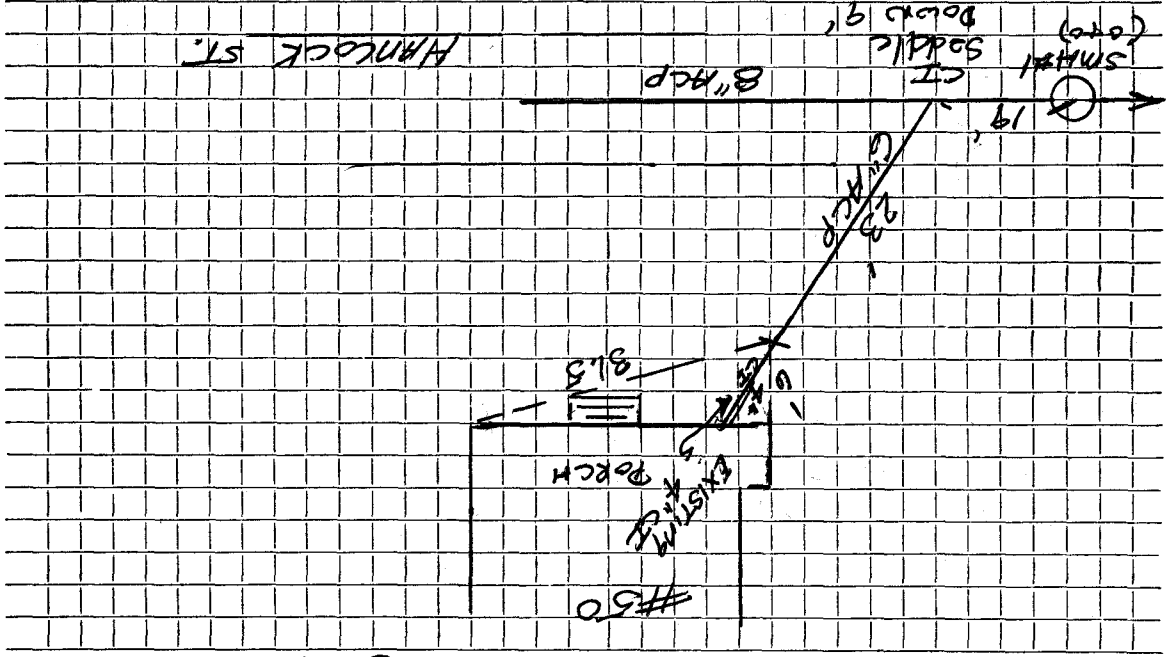

50

Sketch of Service Here

SEWER DIVISION

TOWN OF LEXINGTON — BOARD OF PUBLIC WORKS

DATE