

Name

Service No.

Address #52 HAYCOCK ST.

Location

Kind of Pipe

Size

Size of Main

~~Repair~~—Renewal—~~New~~—Service

Location

Date	Material	Amount	Total	Date	Amount
4/19/79	1265' of 6" ACP	N.C.			
				5/15/79	
					OUTSIDE W.O. # - 0438
					Labor
				2	6" X 22½ Bends
				1	6" X 11½ Bends
				1	4" X 6" Donut
				1	6" X 5' Nip
				1	6" X 8" saddle
				1	Ton ¾ Stone
				10	Hrs. Trucking
				4	Hrs. Loader
				6	Hrs. Shovel


TOWN OF LEXINGTON — BOARD OF PUBLIC WORKS

SEWER DIVISION

DATE _____

52

Sketch of Service Here

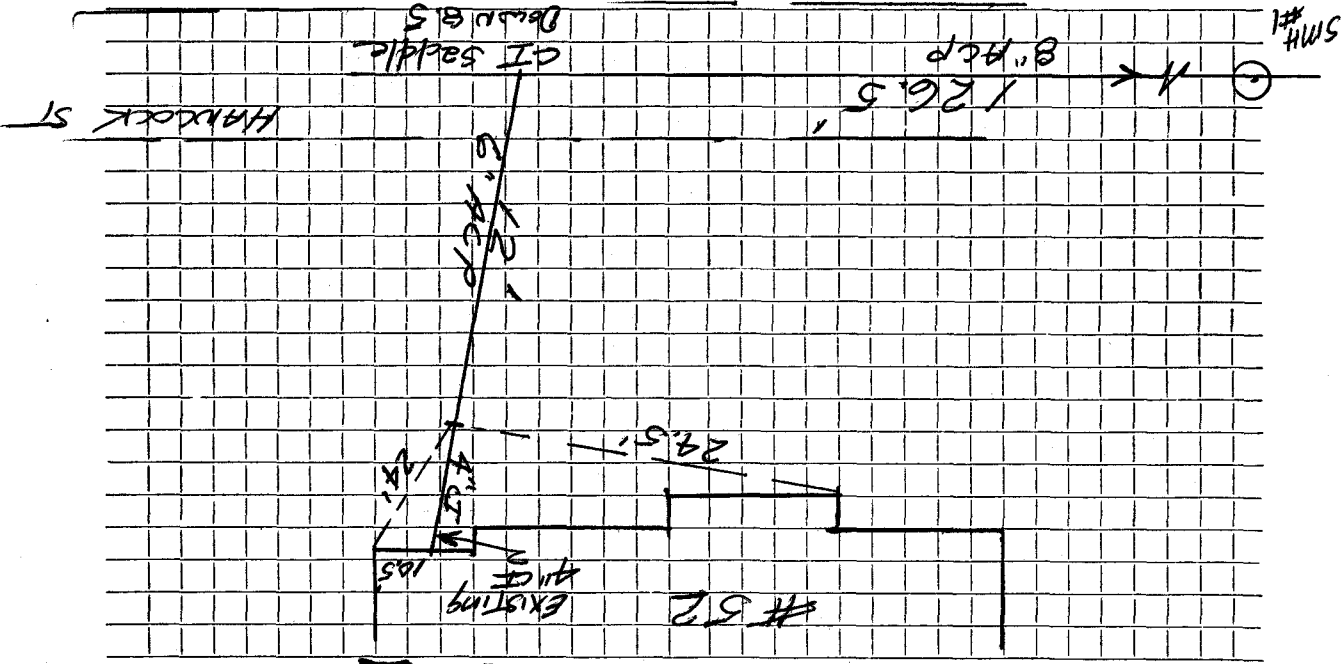

Connection made in **HANCOCK** Street. Work completed

Remarks: **THIS IS A RENEWAL DONE BY THE TOWN PUBLIC WORKS DEPT**

Original Service 1927