


TOWN OF LEXINGTON — BOARD OF PUBLIC WORKS

SEWER DIVISION

DATE _____

53455

Sketch of Service Here

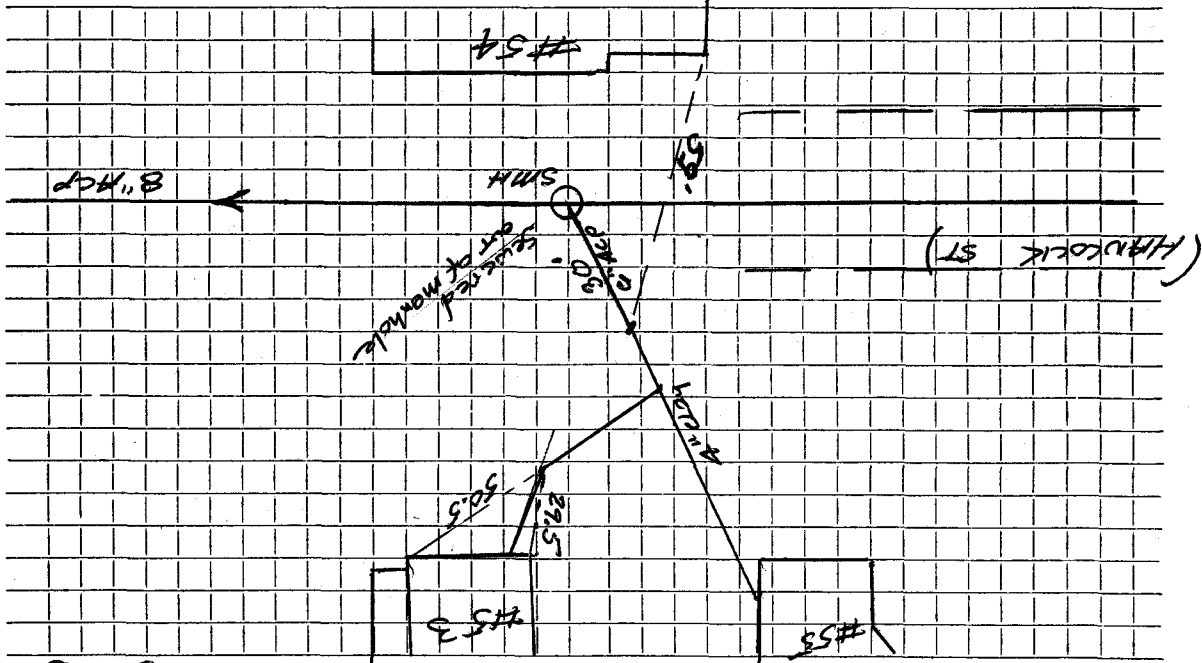

(HANCOCK ST)

HANCOCK

SMH

#54

#53

#53

Connection made in HANCOCK ST. Street.
 Remarks: House No's 53 & 55 used same service. The Public works Dept. Renewed only 30' of pipe with 6" pipe. Original service 1927

Work completed