




TOWN OF LEXINGTON — BOARD OF PUBLIC WORKS

SEWER DIVISION

DATE \_\_\_\_\_

Sketch of Service Here

54

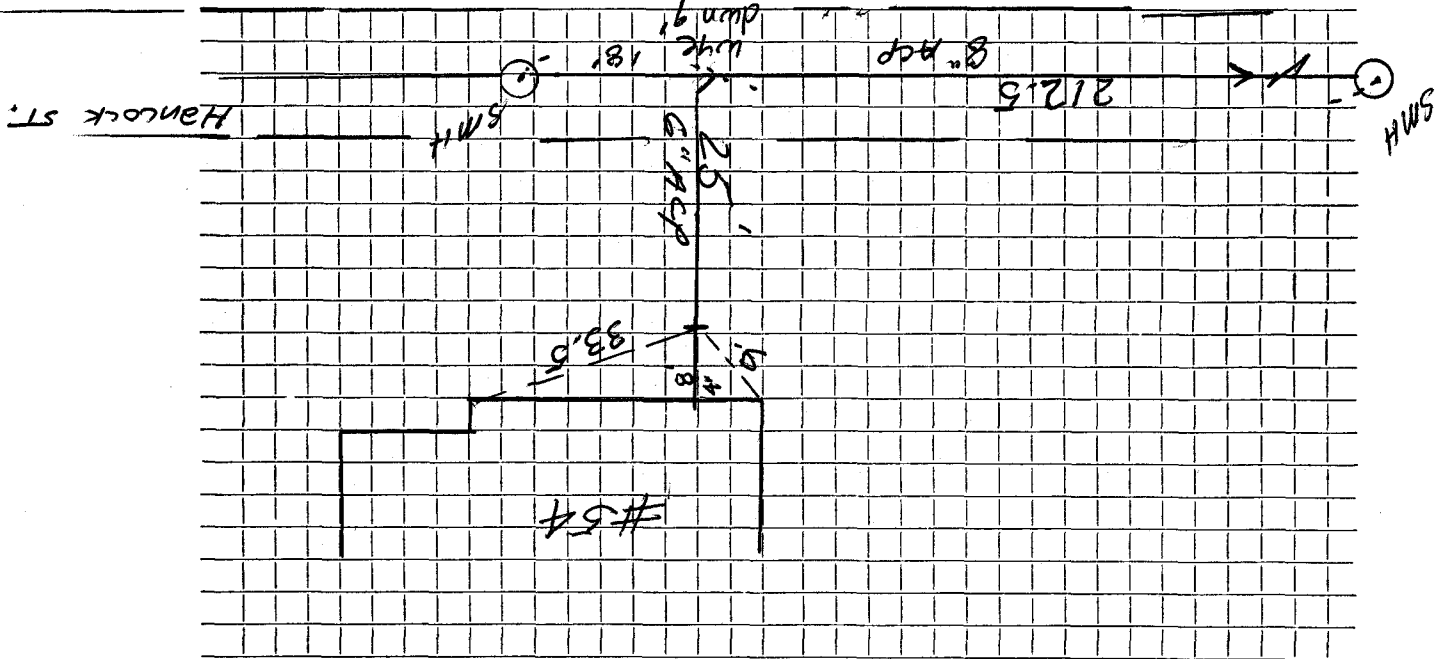

HANCOCK

Street

Work completed

Connection made in

Remarks: THIS IS A RENEWAL done by the Town Public Works Dept

Original Service 4-20-27