




TOWN OF LEXINGTON — BOARD OF PUBLIC WORKS

SEWER DIVISION

DATE 27 OCTOBER 1994

55B

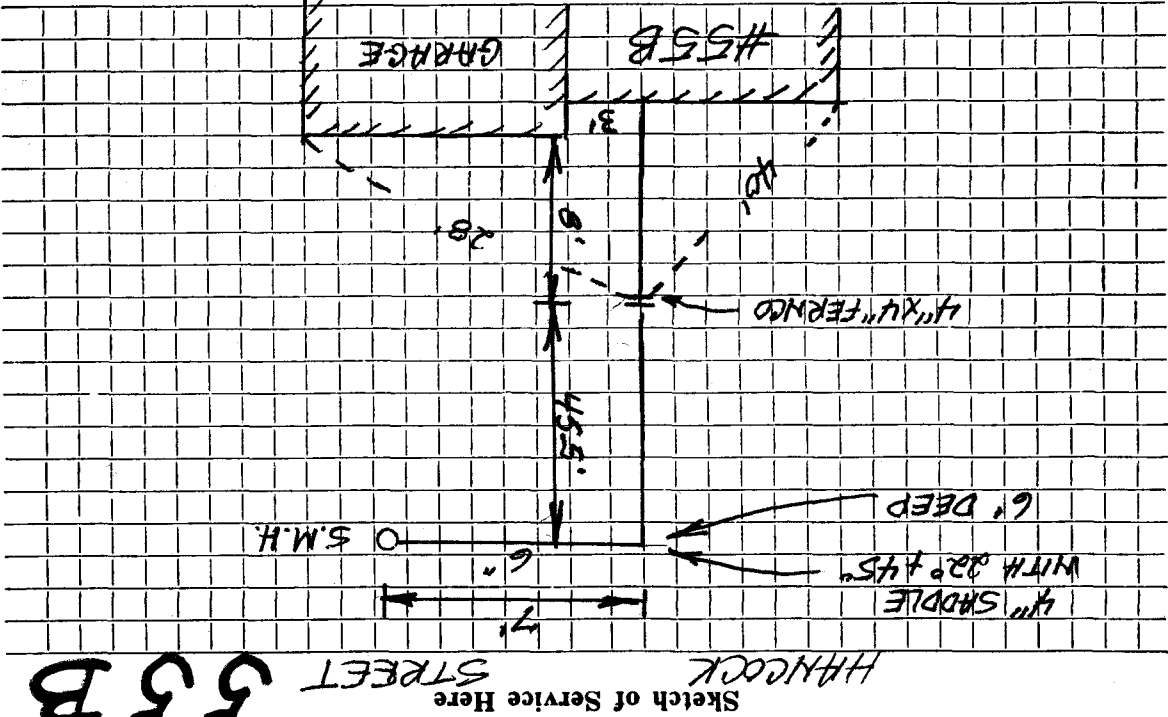

Connection made in HANGCOCK STREET. Work completed. E. BARKS

Remarks:

ROW OR W

TM