

Name Moore Realty Trust Service No. 175

Address 59 Hancock Street

Kind of Pipe _____ Size _____ Location _____

Size of Main _____ Location *Burn 10 24 60*

~~Register~~ - New Service

Date	Material	Amount	Total	Date	Amount
9-19-60	Labor	57.22		9-2-60	
	10% O.H.	5.72	62.94	4-24-60	
	75' 6" Transit pipe @.78		58.50		
1	6" 90° Transit Elbow		5.40		
3	hrs. Town Shovel @6.50		19.50		
2	hrs. Trucking @3.00		6.00		
1	hr. Trojan Loader @3.00		3.00		
20	x 3 Patch		<u>20.00</u>		
			<u>175.34</u>		

Deposit
Returned


246.00
24.66
175.34

TOWN OF LEXINGTON — BOARD OF PUBLIC WORKS

SEWER DIVISION

DATE _____

Sketch of Service Here **59**

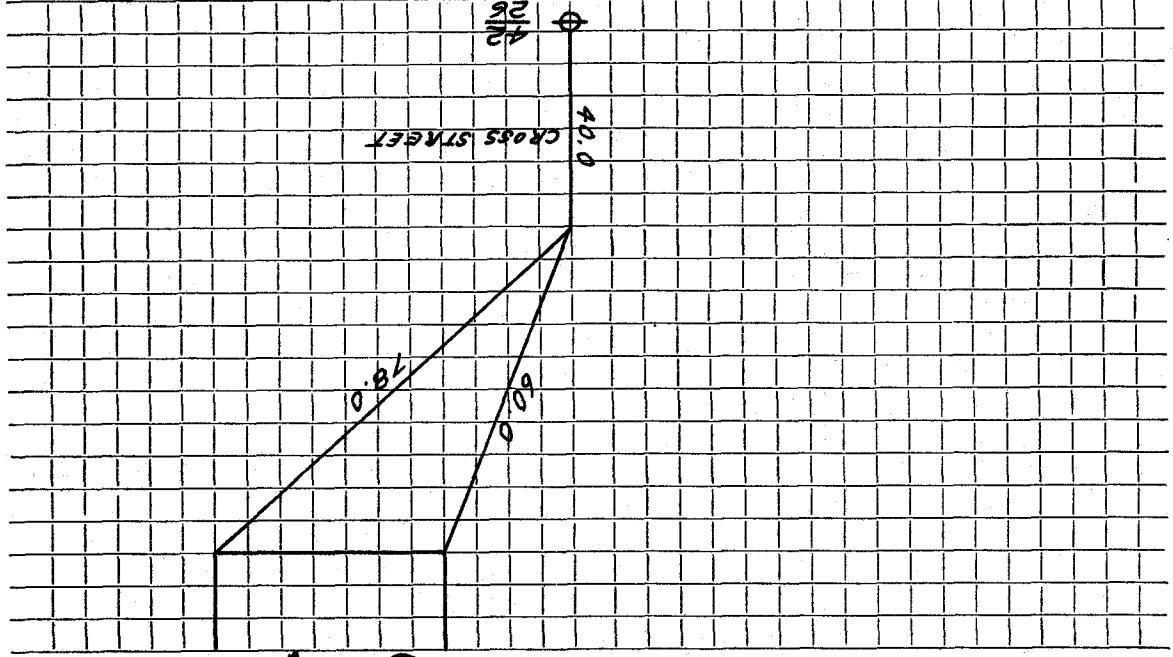

Connection made in Street. Work completed

Remarks: