

Name: Ted Freeman

Service No. 114

Address 61 Hancock Street

Location

Kind of Pipe

Size

Size of Main

WATER SERVICE - New Service W.O. # 2713 Eagle # 5594 Location FEB 10 1975

Date	Material	Amount	Total	Date	Amount
1-18-74	Labor	77 28		1-4-74	580 00
2-08-74	Labor	22 50		5-10-75	85 81
	10% O.H.	9 98	109 76		365 81
20' 6" Transite Pipe		1 24	24 80		
1 6"x10" C.I. Saddle			12 29		
1 6"x6" Nipple			1 76		
1 6"x90 El			5 63		
1 5'x6" Nipple w/coupling			8 00		
1 6" Cap			2 89		
2 Mrs. Trucking @ 3.00			6 00		
2 Mrs. Trucking @ 1.50			3 00		
2 Mrs. Town Shovel			13 00		
1 Mr. Loader			4 00		
1 Mr. Compressor			5 00		
1 Patch 4"x80'			63 00		
1 Patch 5'x24'			106 00		
170' 6" Transite Pipe					
			\$365 81		

Deposit
Paid by W.H. # 39

Non-Charge Work
Labor

170' 6" Transite Pipe


TOWN OF LEXINGTON — BOARD OF PUBLIC WORKS

SEWER DIVISION

DATE

61

Sketch of Service Here

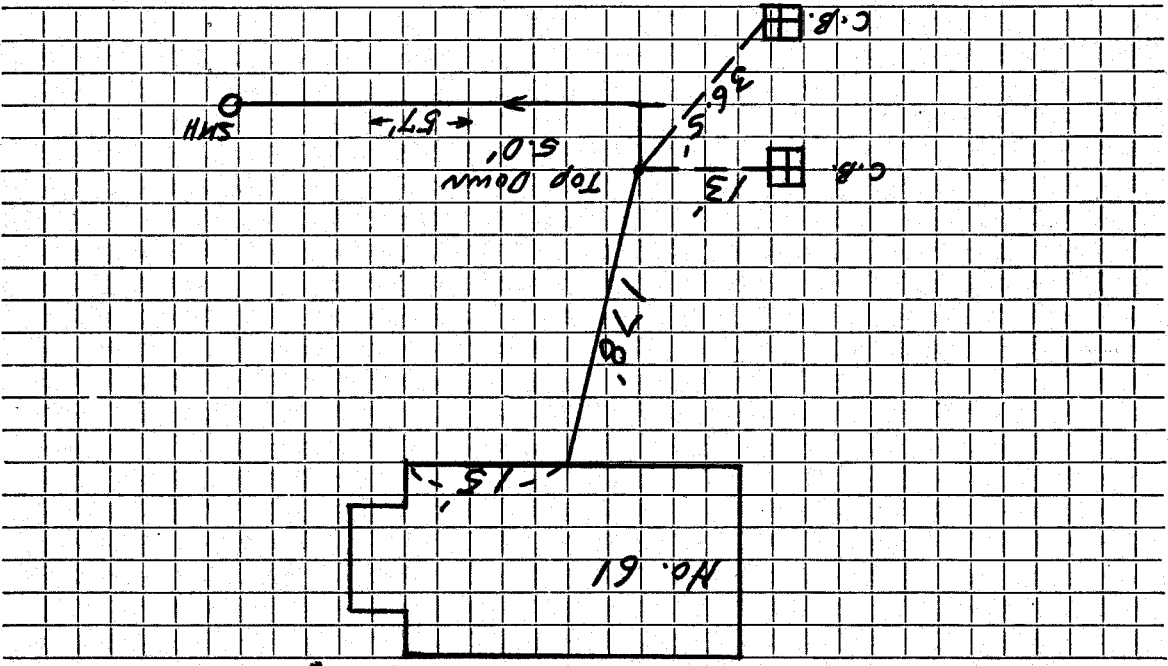

Connection made in Hancock Street. Work completed

Remarks: