

Name

Service No.

Address

63 Hancock St. Location

Kind of Pipe Size

Size of Main

Repair—Renewal—New Service

Location

Date	Material	Amount	Total	Date	Amount


TOWN OF LEXINGTON — BOARD OF PUBLIC WORKS

SEWER DIVISION

DATE \_\_\_\_\_

63

Sketch of Service Here

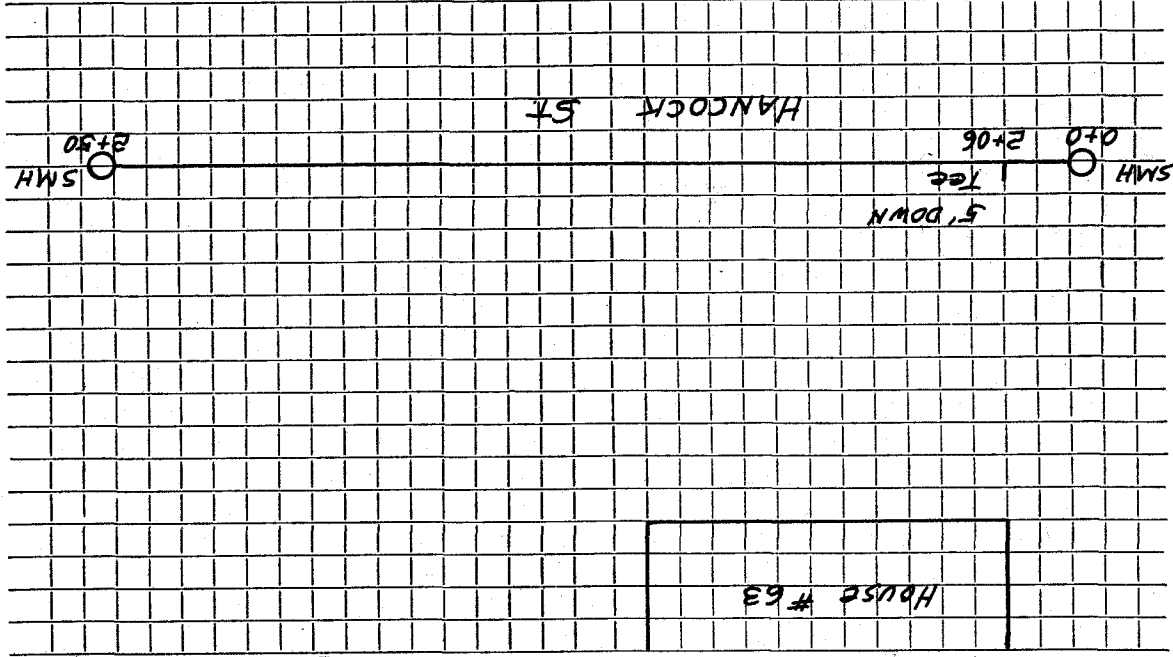

Connection made in \_\_\_\_\_ Street. Work completed \_\_\_\_\_


Remarks: \_\_\_\_\_



TOWN OF LEXINGTON — BOARD OF PUBLIC WORKS

SEWER DIVISION

Sketch of Service Here

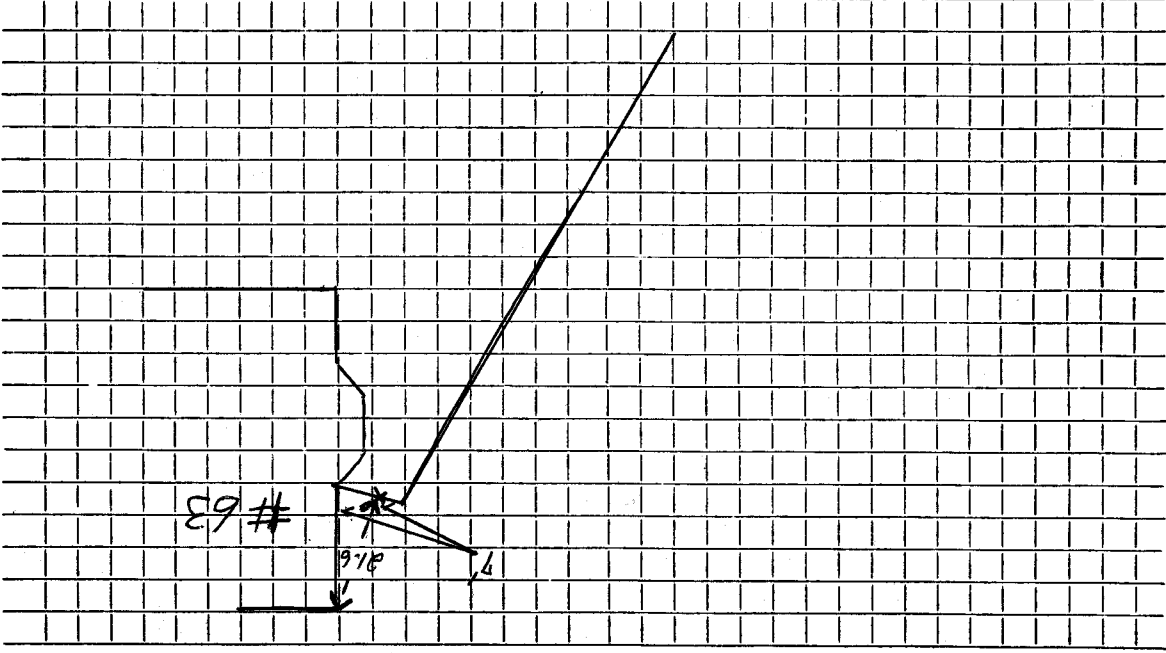

Connection made in ..... Street. Work completed .....  
Remarks: ..... Service 5' deep. & house.

DATE

6-11-02