

Name Peter L. Kaleta

Service No. 217

Address 68 Hancock Street

Location

Kind of Pipe

Size

Size of Main

~~XXXXXXXXXX~~ New Service

Location

Comm. R. 126

Date	Material	Amount	Total	Date	Amount
10-25-60	Labor	54 26		10-11-60	200 00
	10% O.H.	5 13	59 69	10-15-60	45 84
60'	6" Transite pipe @ .78		46 80		154 14
9	1/4 ton gravel @ .85		7 65		
2	Hrs. Town shovel @ 6.50		13 00		
2	Hrs. Trucking @ 3.00		6 00		
1	Hr. Trojan Loader @ 3.00		3 00		
78	x 3 patch		18 00		
			154 14		


TOWN OF LEXINGTON — BOARD OF PUBLIC WORKS

SEWER DIVISION

DATE _____

68

Sketch of Service Here

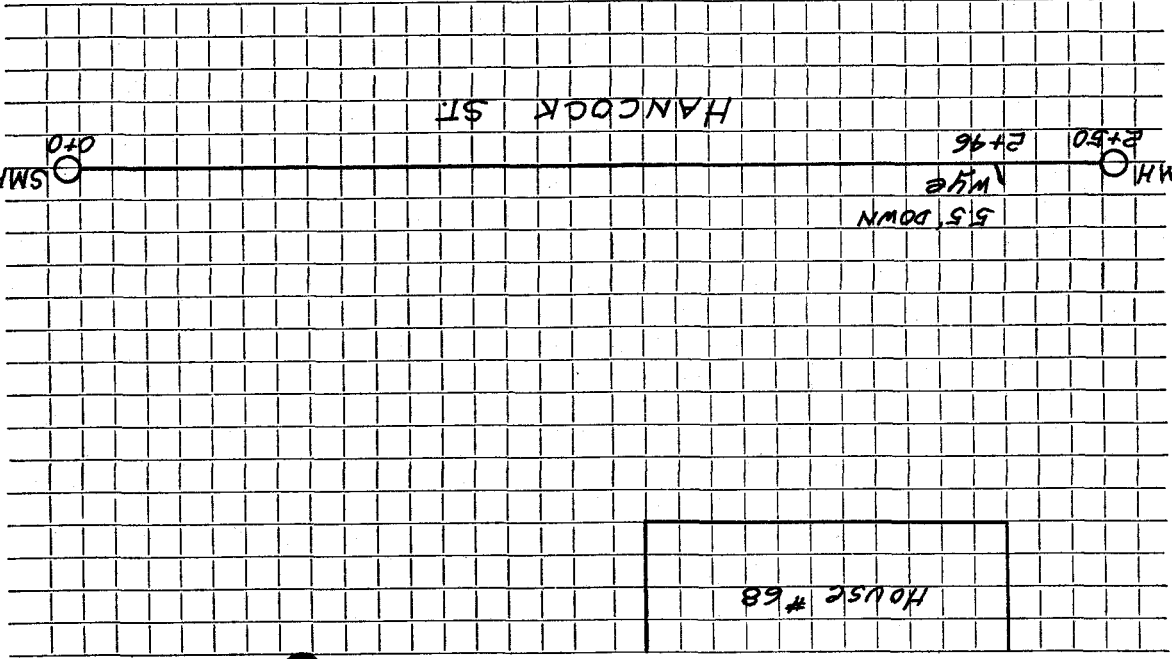

Connection made in Street. Work completed

Remarks: