

Name Louis Stoico Inc.
 Address 71 Hancock Street

Service No. 49

Location

Kind of Pipe _____ Size _____ Size of Main _____

~~XXXXXXXXXXXX~~ - New Service W.O.# 8445 Location Cement 9-21-64


Date	Material	Amount	Total	Date	Amount
6-16-64	Labor	59.97		4-10-64	
	10% O.H.	6.00	65.97	9-21-64	Deposit
	144' 6" Transite pipe @ .82		36.08		Refund
	1 Bag Cement		1.50		
	1 22 $\frac{1}{2}$ " Transite elbow		2.35		
	1 22 $\frac{1}{2}$ " Transite bend		4.09		
	19 X 3 Patch		19.00		
	2 Hrs Town Shovel @ 6.50		13.00		
	3 Hrs Trucking @ 3.00		9.00		
	1 Hr Trailer @ 3.00		3.00		
			<u>153.99</u>		

TOWN OF LEXINGTON — BOARD OF PUBLIC WORKS

SEWER DIVISION

DATE _____

Sketch of Service Here
71

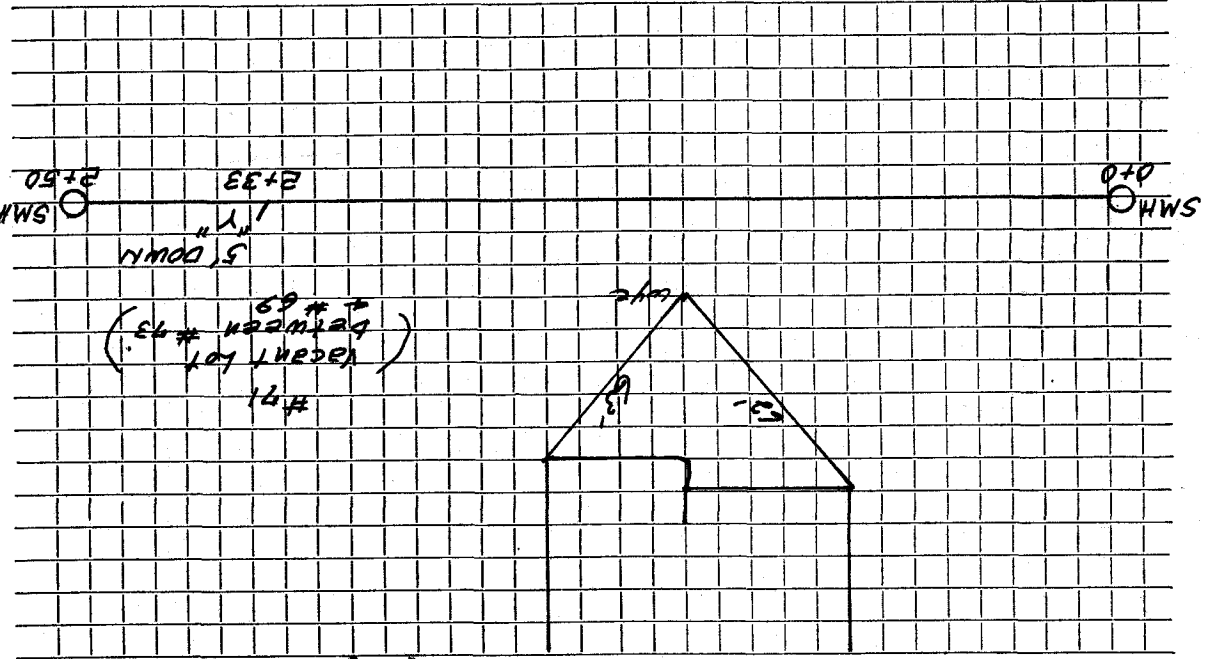

Connection made in Street. Work completed
Remarks: