

Name Moore Homes Inc.

Service No. 179

Address 72 HANCOCK ST Lot 3

Location

Kind of Pipe

Size

Size of Main

Repair—Renewal—New Service W.O.#5938DeFlice #890 Location AUG 5 1968


Date	Material	Amount	Total	Date	Amount
12-7-67	Labor	92.16		11-30-68	225.00
12-8-68	"	11.26	103.42	8-5-68	36.65
	10% O.H.		10.34		184.35
25'	6" Transite pipe @.88		22.00		
1	6 x 10 Saddle		5.50		
1	6" 90° Elbow		4.09		
½	bag cement @1.55		.78		
10	Bricks		.42		
1	ton Hot top		5.80		
3½	hrs. Trucking @3.00		10.50		
2	hrs. Shovel @6.50		13.00		
1	hr. Compressor		5.00		
½	hr. Roller & Trailer		3.50		
			184.35		
2-7-68	40' 6" Transite pipe				
5'	4" Cast Iron pipe				

TOWN OF LEXINGTON — BOARD OF PUBLIC WORKS

SEWER DIVISION

DATE _____

Sketch of Service Here **72**

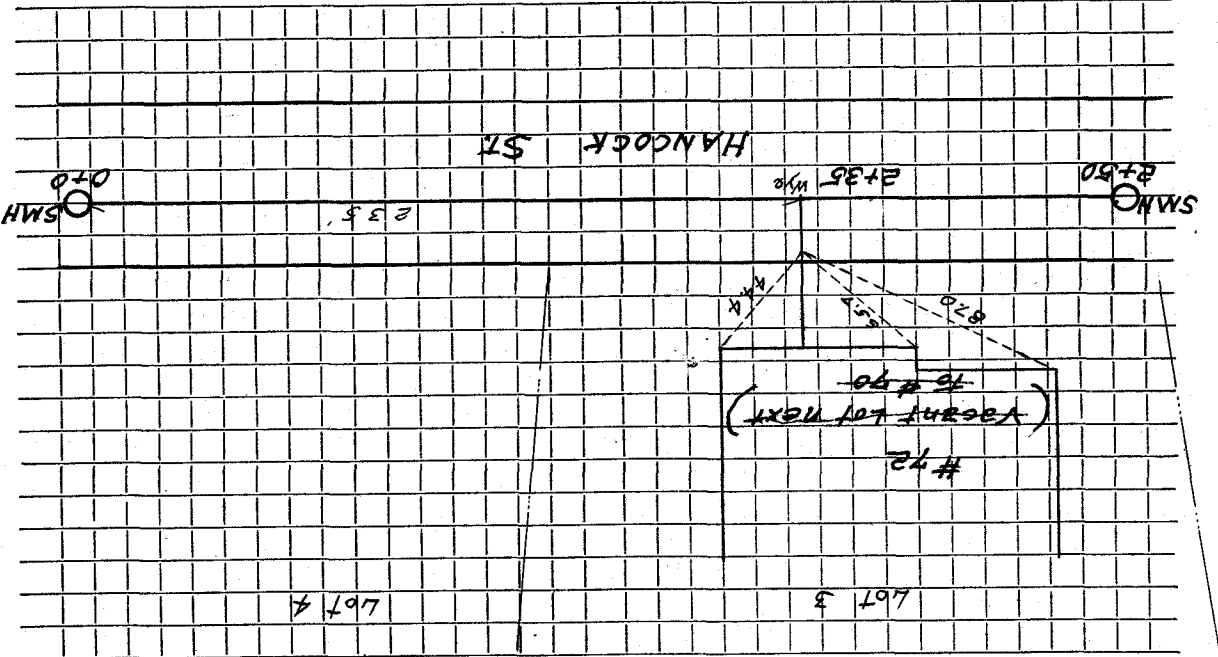

Connection made in _____ Street. Work completed _____

Remarks: _____