

Name Donald White

Service No. 114

Address 73 Hancock Street

Location

Kind of Pipe Russell Sibley Permit #A188

Size of Main

~~Wepson~~ New Service W.O. #1820

Location


JUN 27 1966

Date	Material	Amount	Total	Date	Amount
3-30-66	Labor	68.45		3-15-66	100.00
4-11-66	Labor (P)	35.66	104.11	8-18-66	41.76
	10% O.H.	10.41	114.52		161.76
15'	6" Transite pipe @ .82		12.30		
1	1 1/4" Bend		4.09		
1	1 1/4" Elbow		2.35		
1/4	Ton cold patch @ 5.00		1.25		
1/2	Ton hot top @ 5.50		2.75		
2	Hrs. Truck @ 3.00		6.00		
1/2	Hr. Loader		2.00		
1	Hr. Shovel		6.50		
1	Hr. Roller		3.00		
1	Hr. Trailer		2.00		
1	Hr. Compressor		5.00		
			161.76		
5/3/66	75' 6" Transite pipe				

Billed 5/27/66

SEWER DIVISION

Sketch of Service Here
73

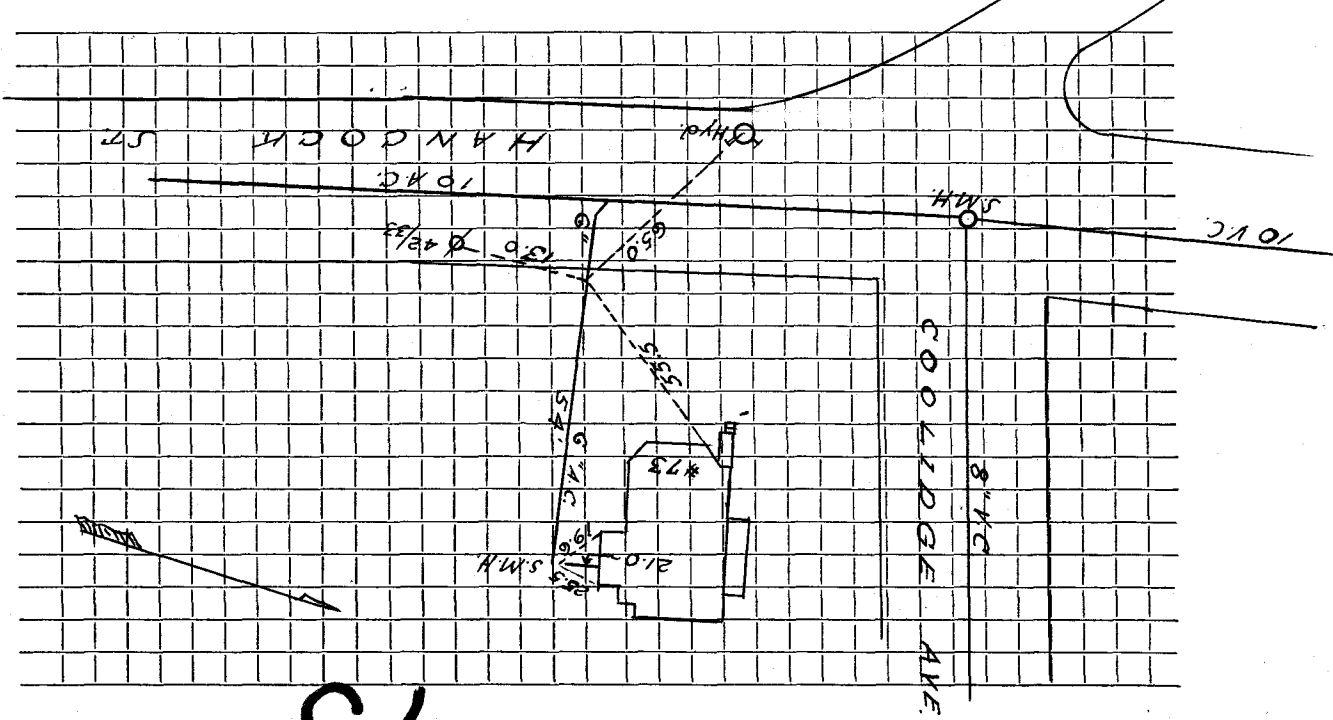

Connection made in _____ Street. Work completed _____
 Remarks: _____

Name

Service No.

Address

73 Hancock St

Location

Kind of Pipe

Size

Size of Main

Repair—Renewal—New Service

Location

Date

Material

Amount

Total

Date

Amount

6-13-05


4X6 PVC to PVC Franco
10' - 4" PVC
6X6X6 wye clean out
2 - 6" 22° Bends
6X6 AC to PVC Franco

TOWN OF LEXINGTON — BOARD OF PUBLIC WORKS

SEWER DIVISION

DATE _____

Sketch of Service Here

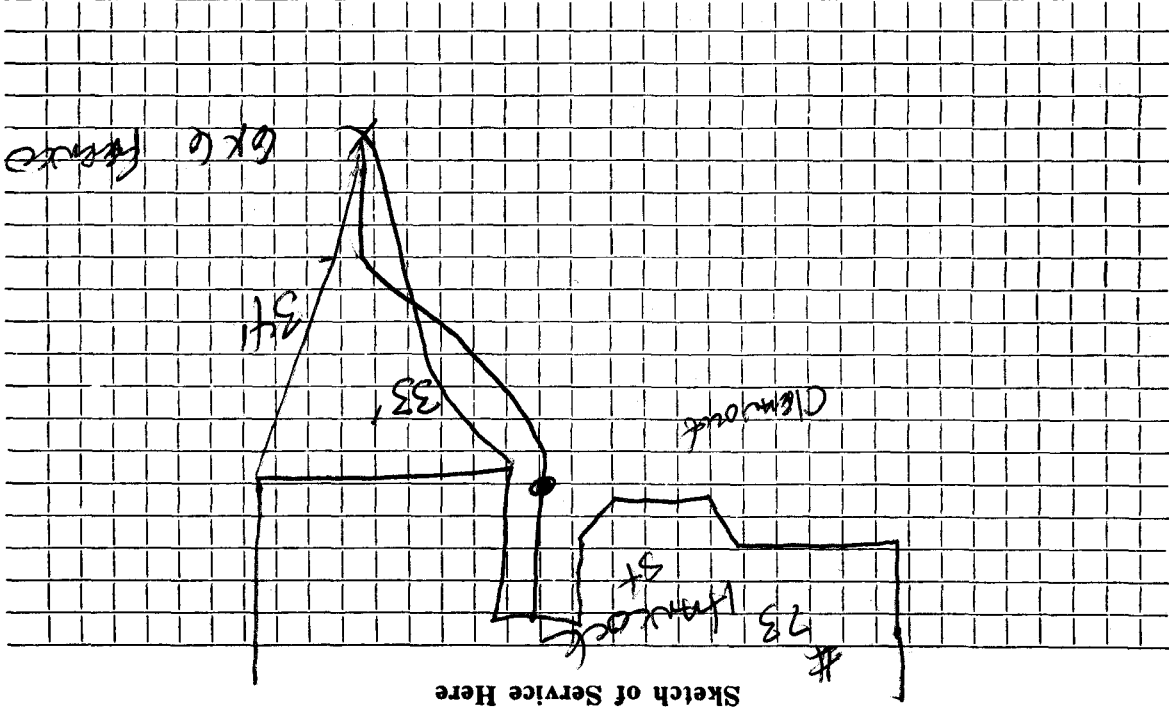

Work completed

Street.

Connection made in

Remarks: