

Name Ralph Hall Service No. 166
 Address 73 A Hancock Street

Kind of Pipe _____ Size _____ Location _____
 Size of Main _____
 Location SEP 5 1967

~~Renewal~~ New Service Lucente #A500
 # 64378

Date	Material	Amount	Total	Date	Amount
1/3/67	Labor	45.90		12-8-66	125.00
4/10/67	Patching	13.33		10-17-67	19.39
	10% O.H.	5.92	65.15	1-5-67	144.39
20'	6" Transite Pipe		17.60	25' 6" Transite	
2	Bags Cement		3.10		
4	Doz. Bricks		2.04		
2	Ton Cold Patch		10.00		
3	Ton Hot Top		16.50		
3	Hrs. Trucking		9.00		
2	Hrs. Shovel		13.00		
1	Hr. Roller		3.00		
1	Hr. Compressor		5.00		
			114.39		
4/5/67	25' 6" Transite pipe				

Bill sent 19.39


TOWN OF LEXINGTON — BOARD OF PUBLIC WORKS

SEWER DIVISION

DATE _____

Sketch of Service Here

73 A

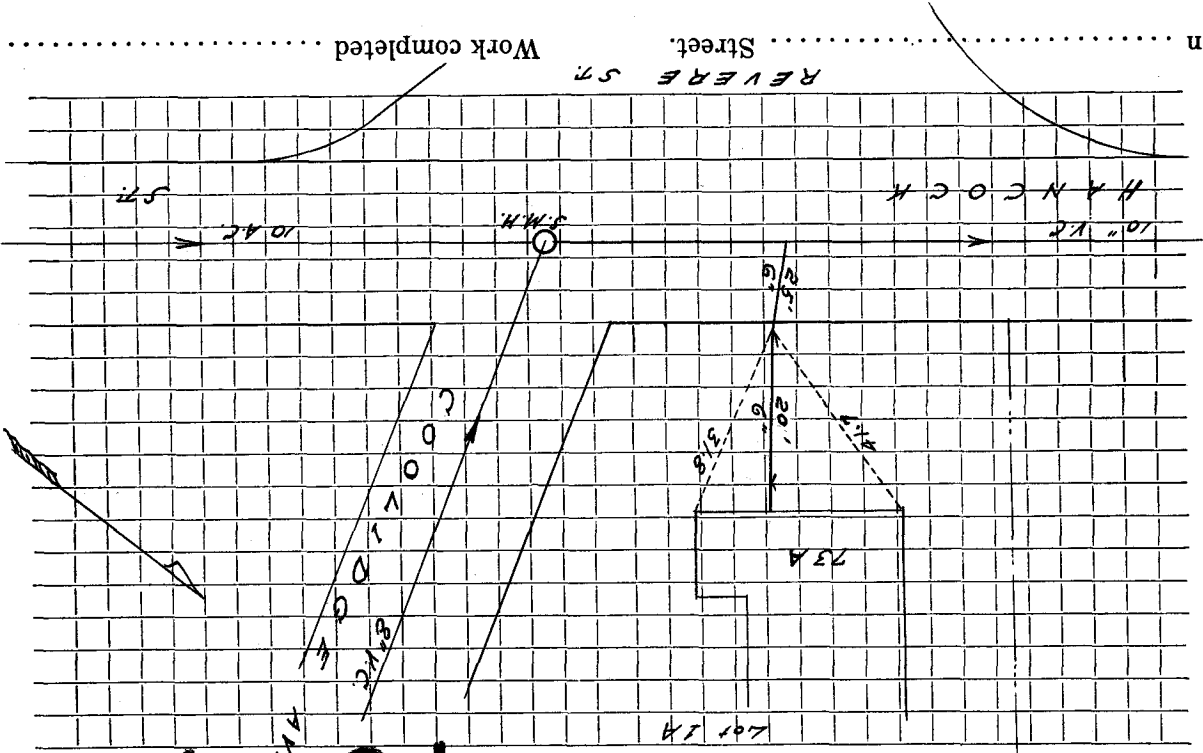

Connection made in
Remarks: