

Name Moore Homes Inc.

Service No. 1


Address 74 Hancock Street

Location

Kind of Pipe Size Size of Main
~~Repair~~ ~~Renewal~~ ~~XXXXXX~~ New Service W.O. # 7325 DeFlice Bros. #1543 Location **JUL 27 1970**

Date	Material	Amount	Total	Date	Amount
3/16/70	Labor	68 96		4-22-70	211 00
4/17/70	"	37 91		7-27-70	7 85
10%	O.H.	10 69	117 56		202 15
25'	Transite pipe .90		22 50	3-16-70	
1	6" Plug		3 80	25' 6" Transite	
3	6" Couplings 1.53		4 59		
1	Ton cold patch		5 90		
2	Ton hot top 5.80		11 80		
2 1/2	Hrs. Trucking 3.00		7 50		
2 1/2	" " 1.50		3 75		
2 1/2	" shovel 6.50		16 25		
1	" compressor		5 00		
1/2	" roller 3.00		1 50		
	Trailer		2 00		
			202 15		
4-8-70	50' 6" Transite pipe				
	10' 4" Cast Iron pipe				

SEWER DIVISION

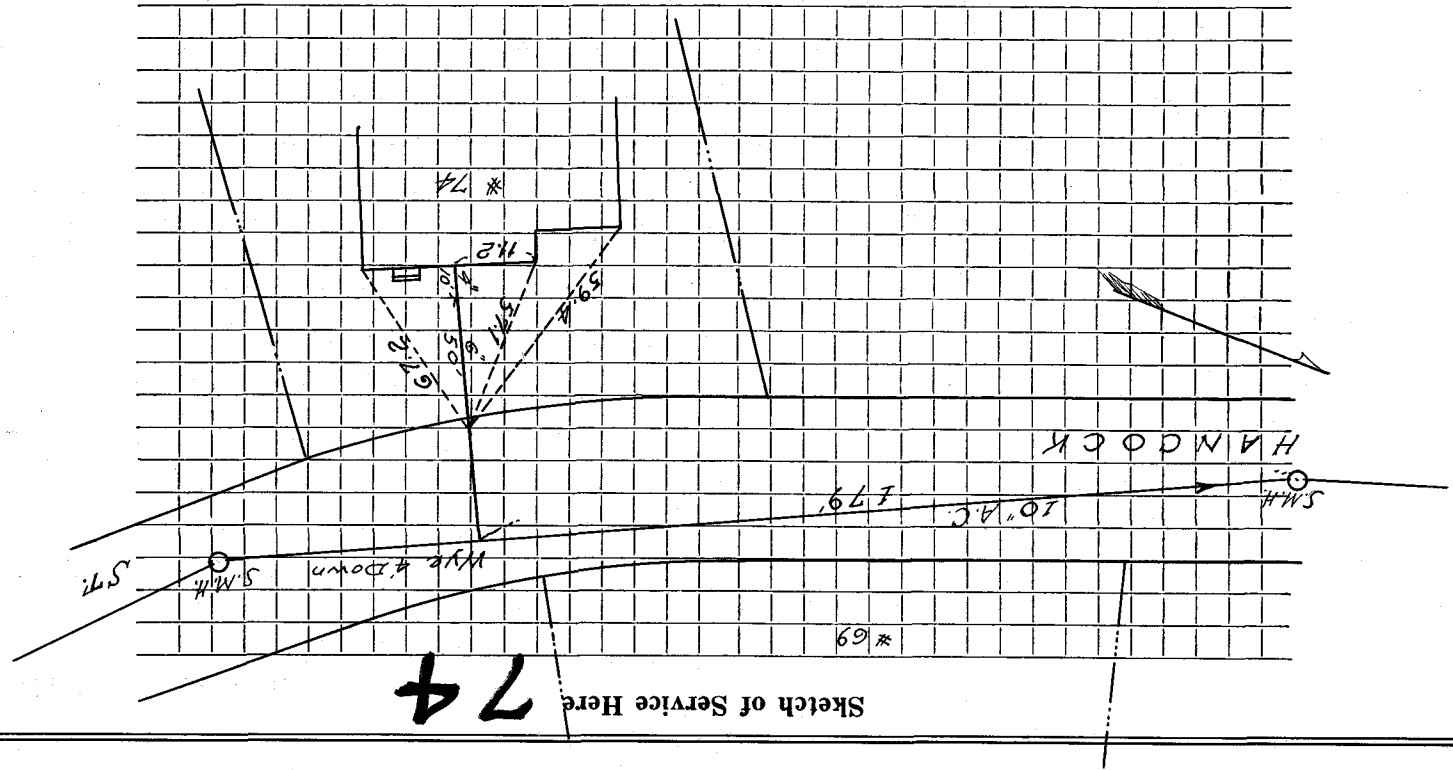

Connection made in Street. Work completed

Remarks: