


TOWN OF LEXINGTON — BOARD OF PUBLIC WORKS

SEWER DIVISION

DATE _____

Sketch of Service Here

76

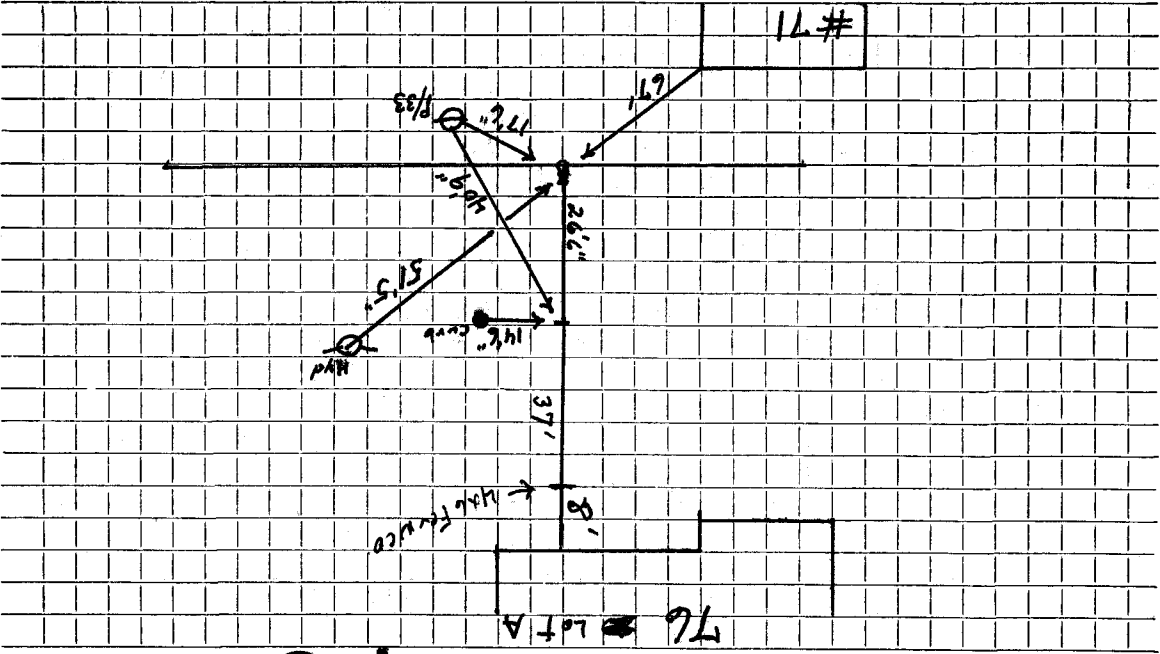

Connection made in Hancock St

Street.

Work completed

Remarks: