

Name Robert H. Murray
 Address 77 Hancock Street
Lexington

Service No. 4

Location

Size of Main

Size

Location

~~XXXXXXXXXX~~ New Service COM. 2-25-52

Date	Material	Amount		Total	Date	Amount
2/11/52	Labor	26	72		2-8-52	Deposited 125 00
2/12/52	"	51	86	78 58	2-25-52	Re-fund ed (8 30
	10% overhead			7 86		116 70
	42' - 6" sewer pipe @ .342			14 36		
	1 - 6" elbow			1 88		
	joint compound			2 52		
	2 hrs. trucking			1 50		
	patching 10 x 3			10 00		
				<u>116 70</u>		
	Labor					

TOWN OF LEXINGTON—DEPT. OF PUBLIC WORKS

SEWER DIVISION

DATE NO.


The undersigned applies for the construction of a particular sewer connecting No. Street and hereby agrees to comply with the Rules and Regulations governing the construction and use of Particular Sewers, as now or at any future time established by the Board of Selectmen.

Am't of estimate \$.....

Am't Paid \$.....

Owner

Sketch of Service Here

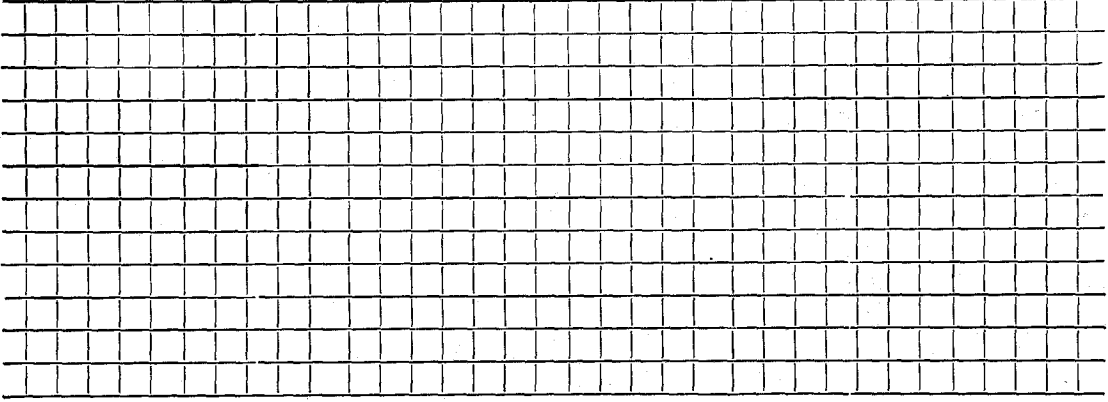

Connection made in Street. Work completed 19..

Remarks: