

Name J. F. Collins

Service No. 118

Address 79 Hancock Street

Location

Kind of Pipe Size Size of Main Location

Repair/Renewal—New Service COM. 9-13-54

Date	Material	Amount	Total	Date	Amount
8/10/54	Labor	51 90		7-22-54	125 40
	10% overhead	5 19	57 09	9-13-54	11 57
	36' - 6" sewer pipe @ .30		10 80		113 43
	1 - 6" elbow		1 88		
	joint compound		2 16		
	4 hrs. Littlefield shovel @ 7.50		30 00		
	2 hrs. trucking @ .75		1 50		
	patching 10 x 3		10 00		
			113 43		
	Labor			3-24-67	
				Don't know	

TOWN OF LEXINGTON—DEPT. OF PUBLIC WORKS

SEWER DIVISION

DATE NO.


The undersigned applies for the construction of a particular sewer connecting No. Street and hereby agrees to comply with the Rules and Regulations governing the construction and use of Particular Sewers, as now or at any future time established by the Board of Selectmen.

Am't of estimate \$.....

Am't Paid \$.....

Owner

Sketch of Service Here

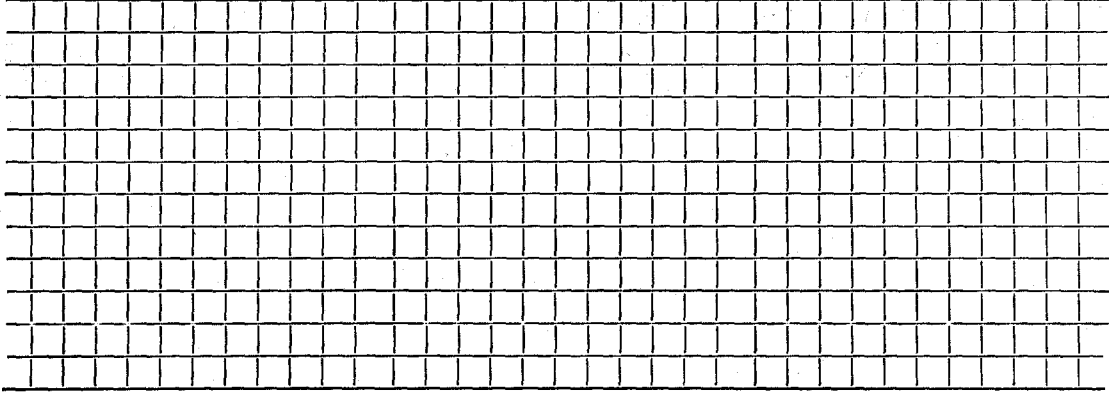

Connection made in Street. Work completed 19..

Remarks: