


TOWN OF LEXINGTON — BOARD OF PUBLIC WORKS

SEWER DIVISION

Sketch of Service Here

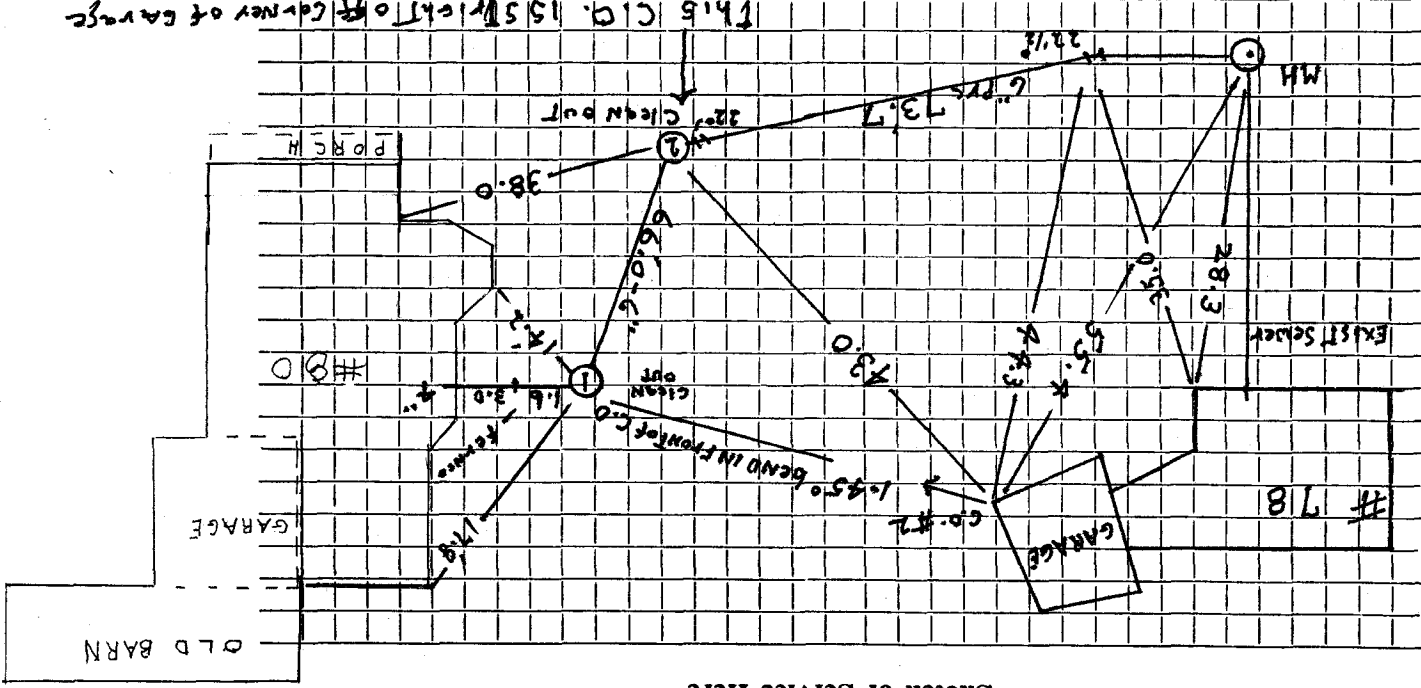

REVERF ST

DATE _____

Connection made in _____ Street.

This C.I.C. IS 15" WRICH TO THE CORNER OF GARAGE GARAGE IS MUCH CLOSER TO ST

Work completed _____

Remarks :